


T.18S.R.42E.W.M.

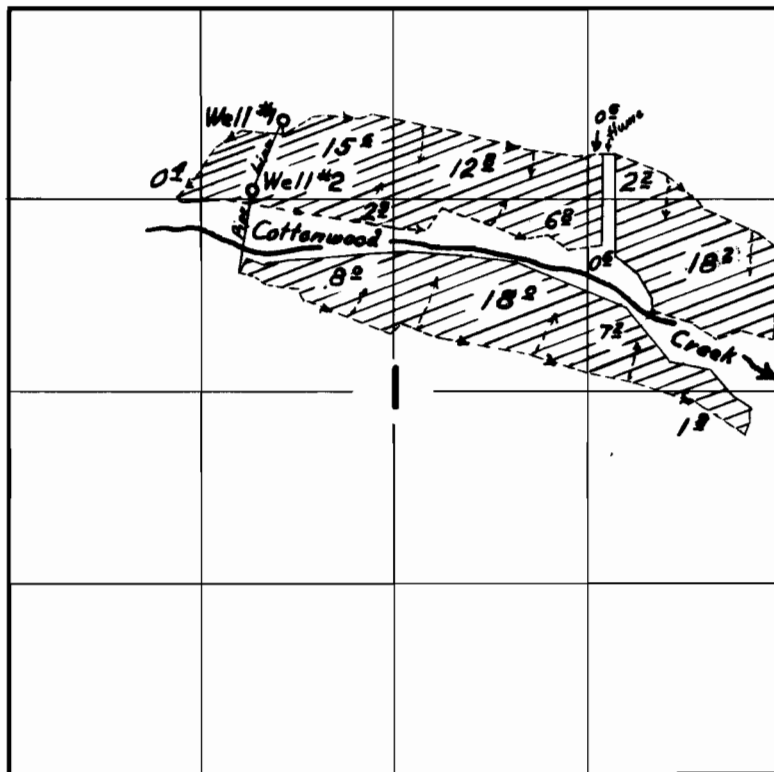

FINAL PROOF SURVEY UNDER

Application No. G-431 Permit No. G-519
IN NAME OF

Thos. C. McElroy Jr.

Surveyed June 7+8, 1962, by Thomas R. Lauer