


T. 18 S. R. 46 E. W. M.

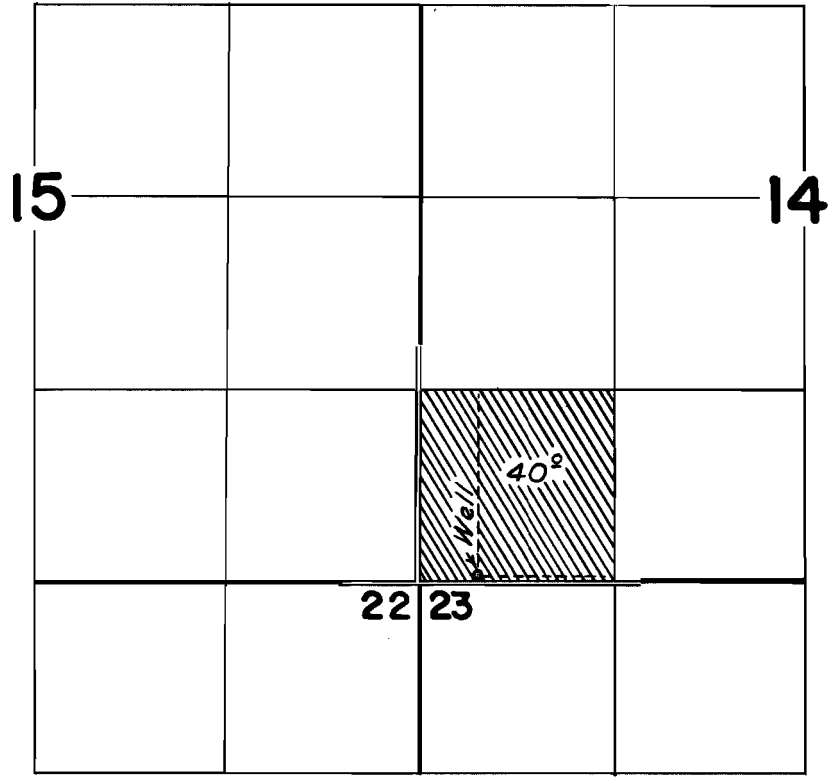

FINAL PROOF SURVEY UNDER

Application No. *G-965* Permit No. *G-919*
IN NAME OF

LEE & LEO MONCE

Surveyed *July 10, 1962*, by *C.R. Baker*