


T. 18 S. R. 47 E.W.M.

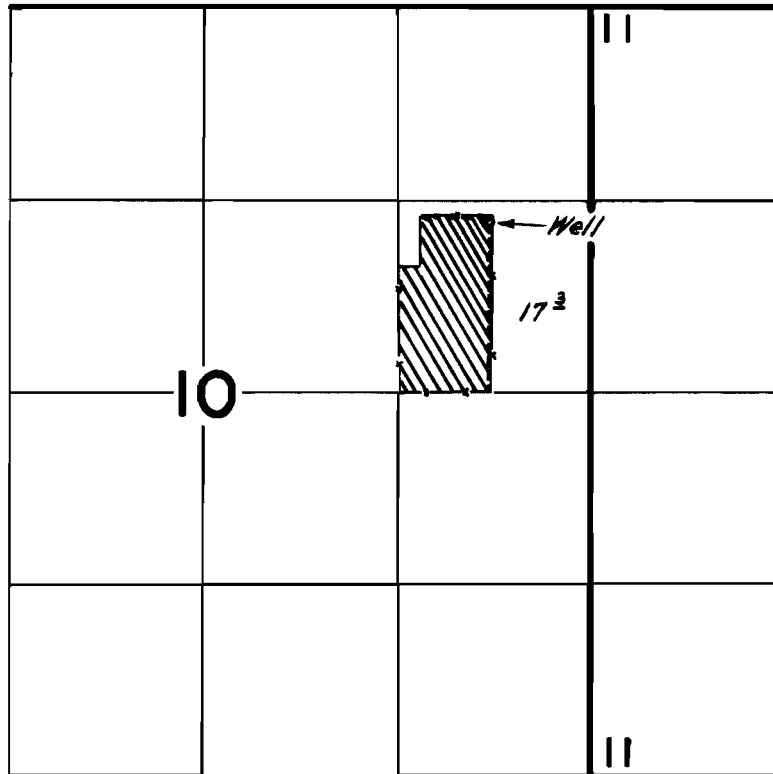

FINAL PROOF SURVEY
UNDER

Application No. *G-1727* Permit No. *G-1581*
IN NAME OF

JOHN I. WELLS

Surveyed *June 8* 19*62*, by *C.R. Baker*