


T. 18 S.R. 45 E.W.M.

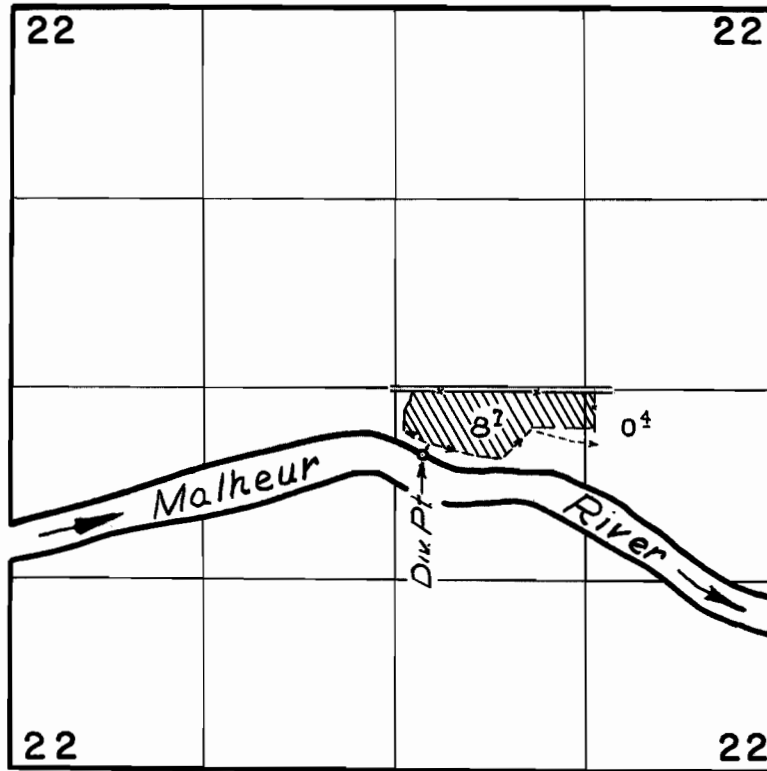

FINAL PROOF SURVEY
UNDER

Application No. *31476*... Permit No. *24887*.
IN NAME OF

ORION L. BEAL

Surveyed *June 6, 1962*, by *C.R. Baker*...