



T. 18 S. R. 45 E.W.M.

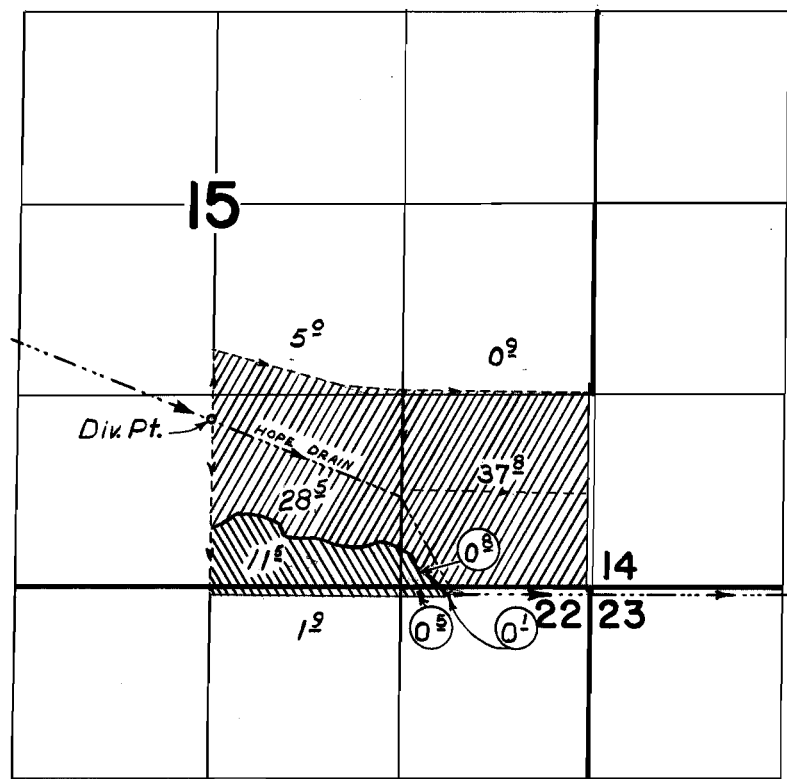

FINAL PROOF SURVEY UNDER

Primary
Supplemental

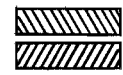

Application No. 32923 Permit No. 26018...
IN NAME OF

JAMES A. RENWICK

Surveyed June 6... 1962, by C.R. Baker.....