


T.6S.R.2W.W.M.

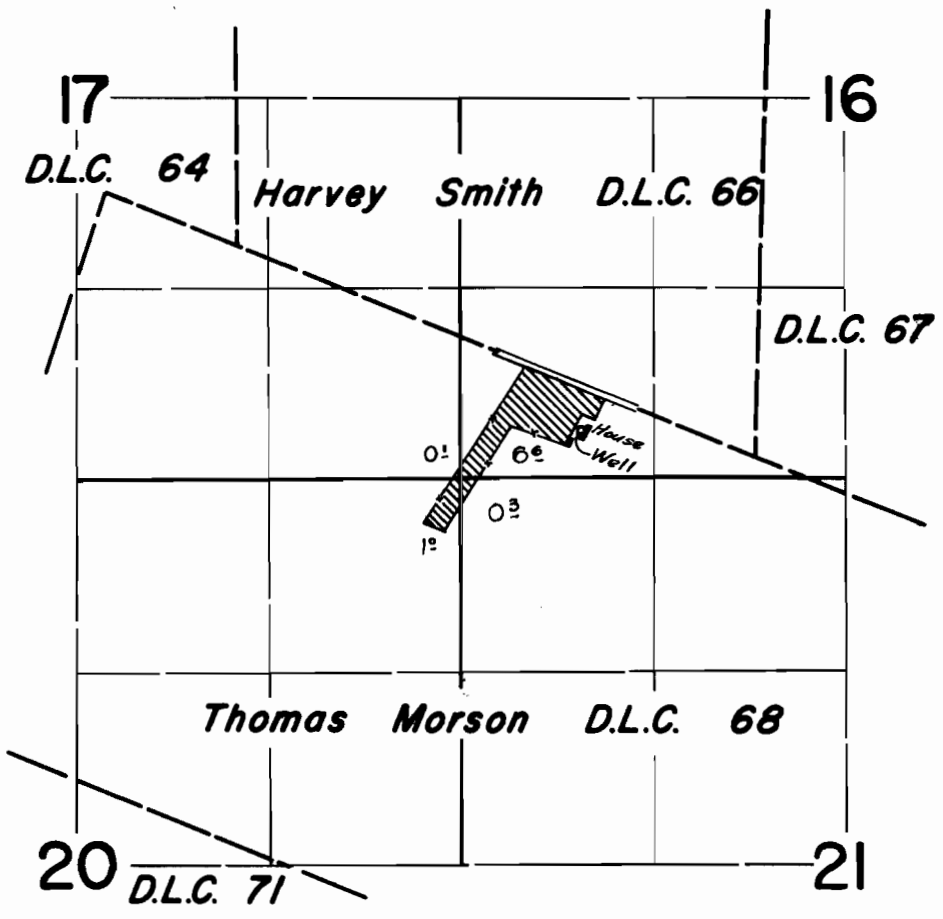

FINAL PROOF SURVEY UNDER

Application No. G-873... Permit No. G-824...
IN NAME OF

GUSTAVE & GERTRUDE ROBERTSON

Surveyed June 18, 1962, by *[Signature]*