


T.IOS.R.3W.W.M.

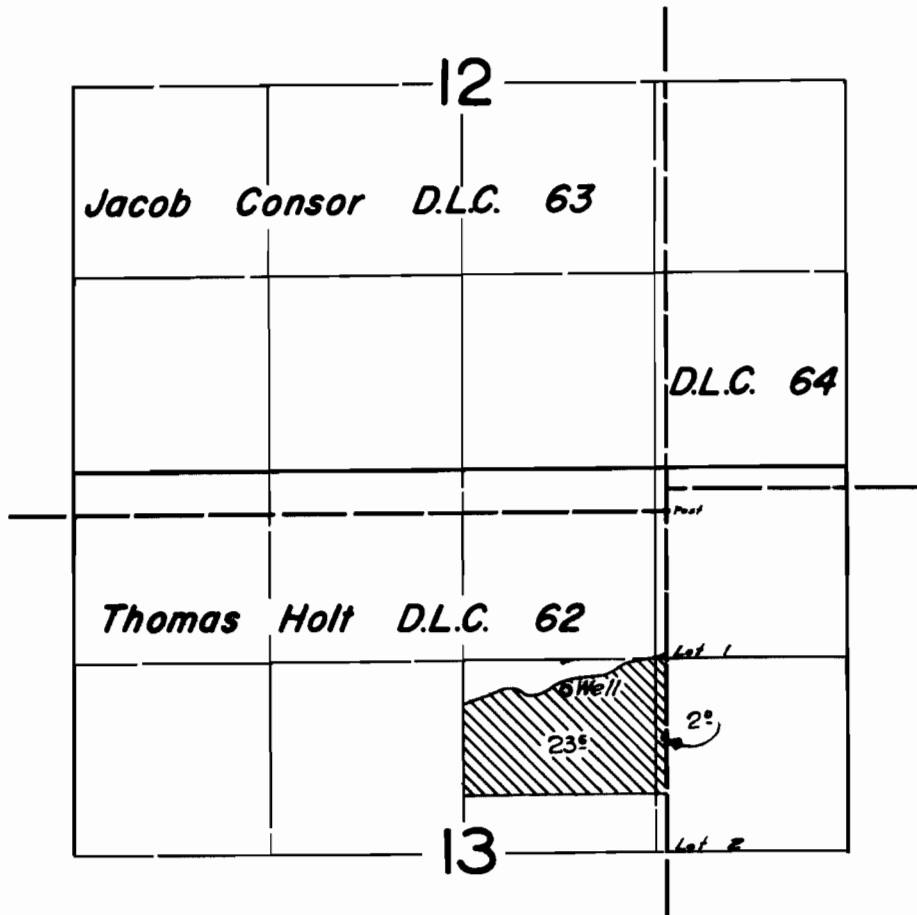

FINAL PROOF SURVEY
UNDER

Application No. G-1489... Permit No. G-1361...
IN NAME OF

LARRY W. WELLS

Surveyed June 21, 1962., by *R. H. Peterson*