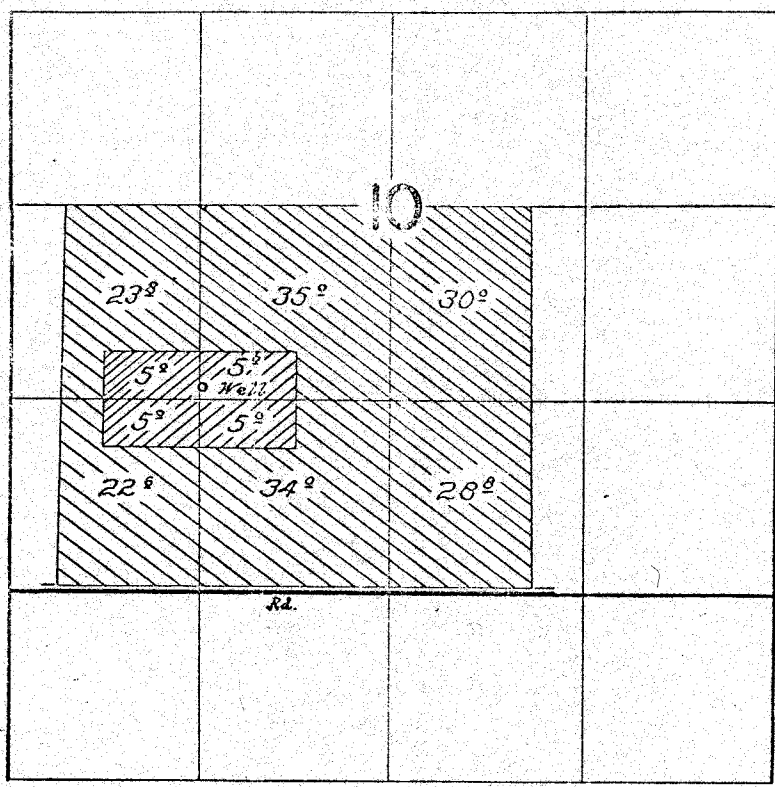

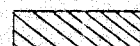


7
U-549
C-31194

T.3N.R.26E.W.M.




U-596


S-1413

FINAL PROOF SURVEY UNDER

Application No. ~~S-1413~~ U-596 Permit No. ~~S-1722~~ U-549 RESURVEYED
IN NAME OF 8/66 by L.E. Gould
..... Ernest P. Cramer

Surveyed Oct. 1, 1962, by Thomas P. Lauer