


U-551  
C-3119S

# T.3N.R.26E.W.M.

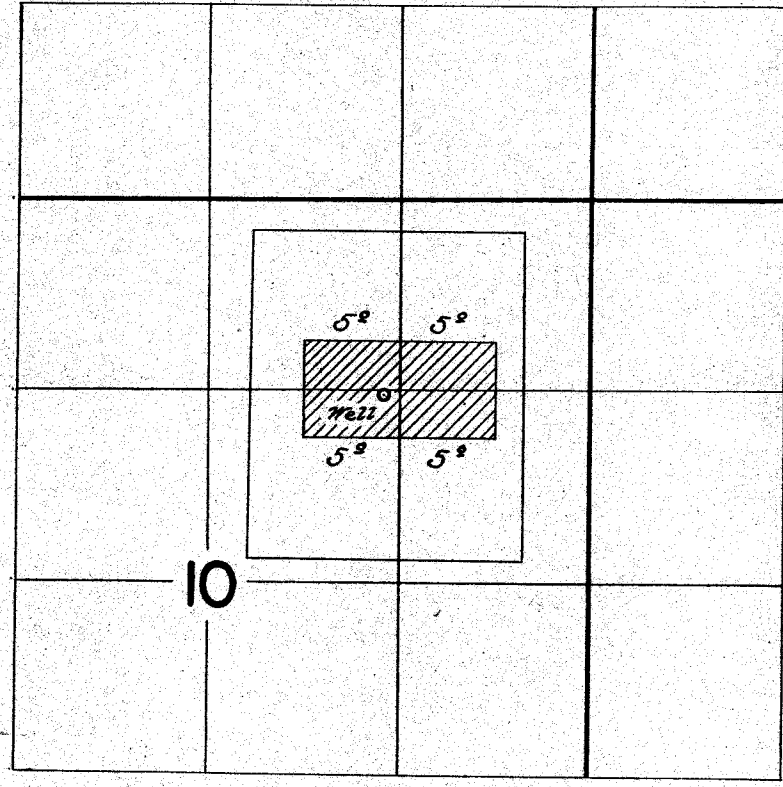

## FINAL PROOF SURVEY UNDER

Application No. U-600 Permit No. U-551  
IN NAME OF

Waldo H. Cramer

Surveyed Sept. 26, 1962, by Thomas R. Lauer