


T.10S. R. 4W.W.M.

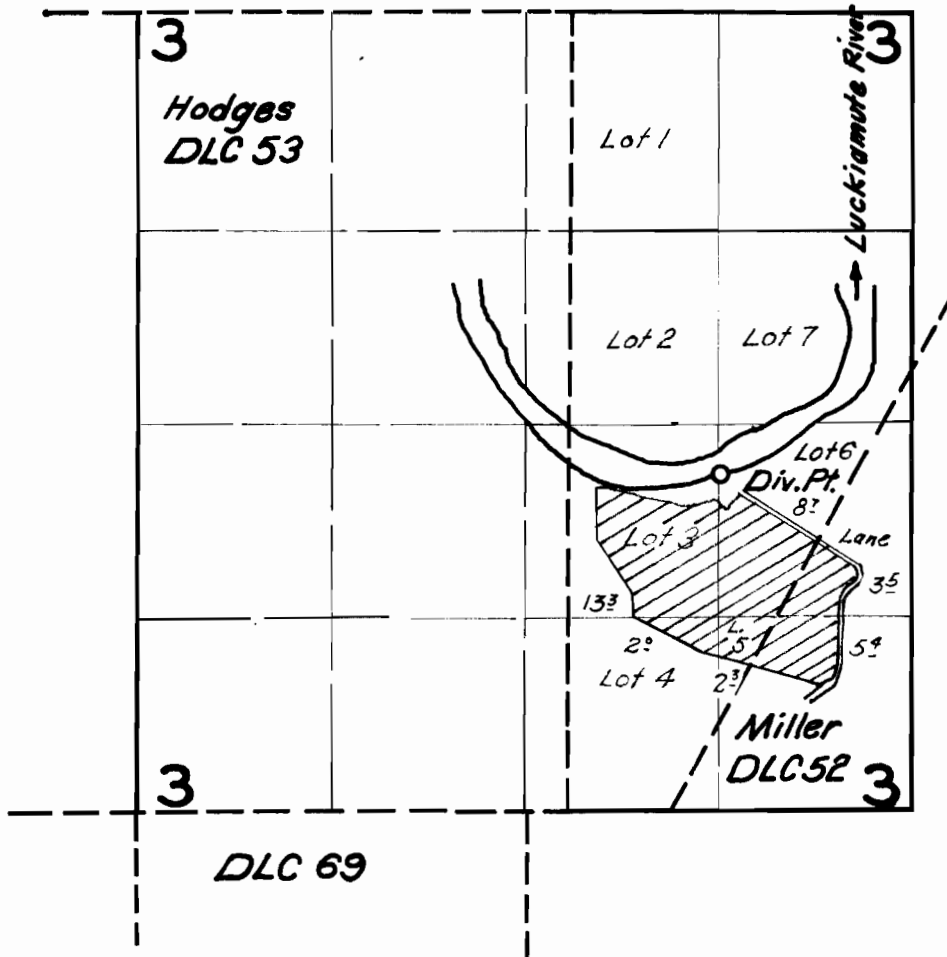

FINAL PROOF SURVEY
UNDER

Application No. 32173 Permit No. 25383
IN NAME OF

Don Turnidge

Surveyed Aug. 30, 1962, by Carl R. Baker