


T.6S. R.3W.W.M.

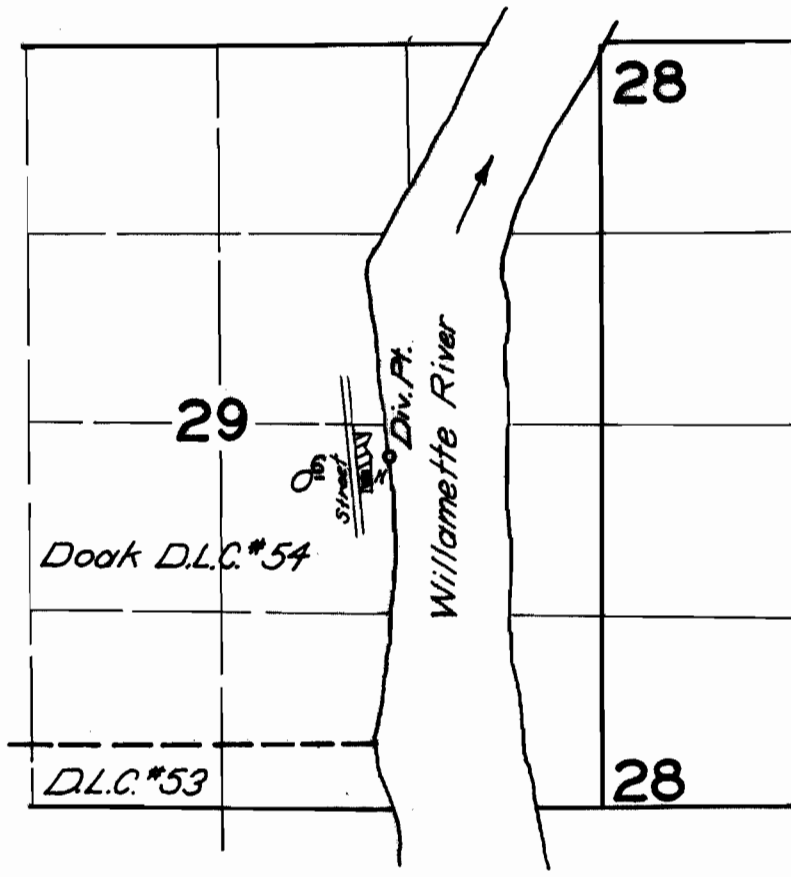

FINAL PROOF SURVEY UNDER

Application No. 32952 Permit No. 26041
IN NAME OF

Wolcott E. Buren

Surveyed Aug. 28 1962., by Carl R. Baker