


T. 1 S. R. 17 E. W. M.

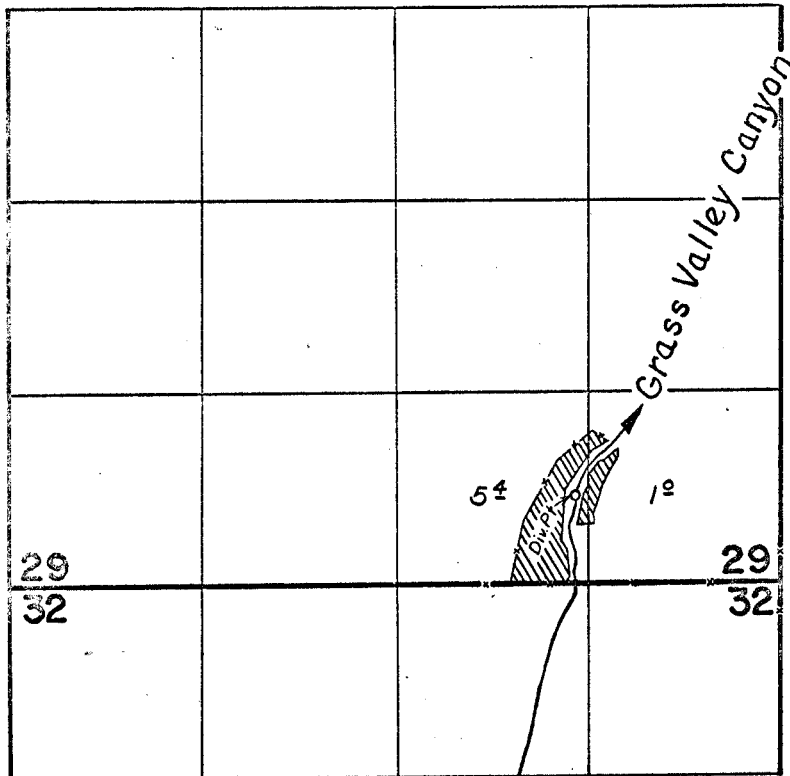

FINAL PROOF SURVEY UNDER

Application No. 32633... Permit No. 25741...
IN NAME OF

.....MERLE MILLER.....

Surveyed Sept 24 1962, by C.R. Baker.....