


T.5&6S.R.10&11W.W.M.

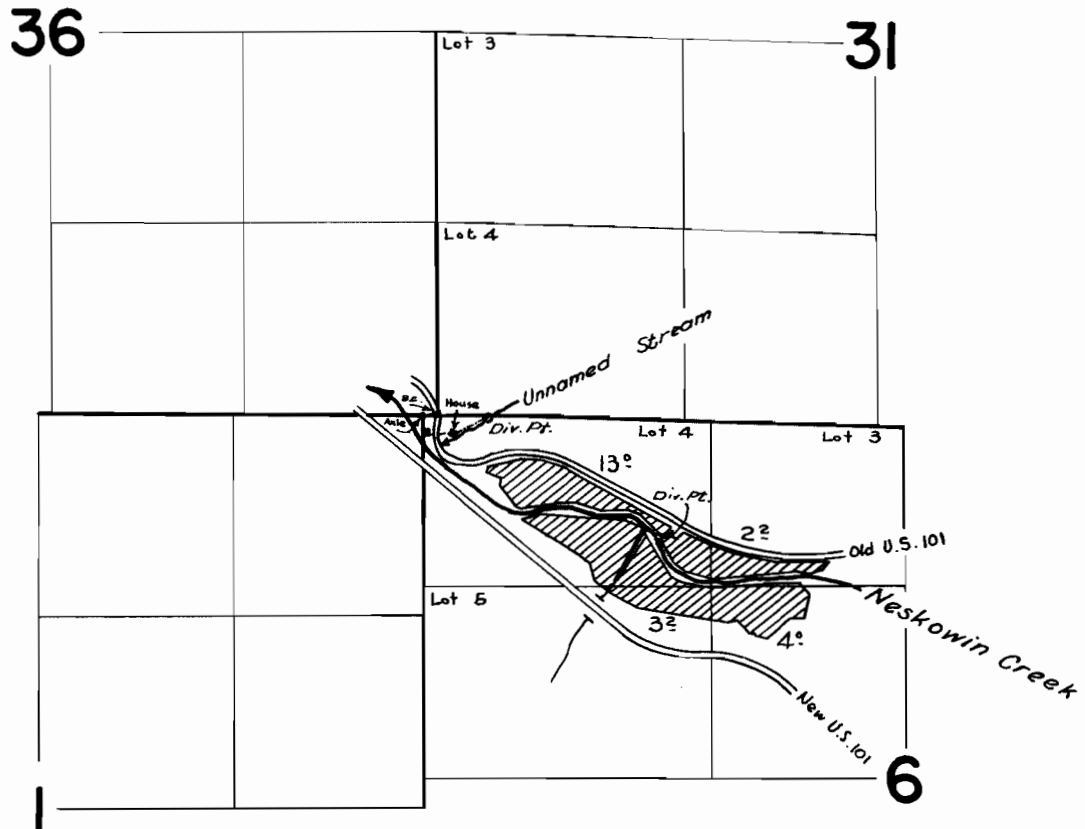

FINAL PROOF SURVEY
UNDER

Application No. **32899** Permit No. **25976**
IN NAME OF

RALPH L. SUTTON

Surveyed July 31, 1962, by

R. Jackson