


U-441 7

C-3126

T.2N.R.27E.W.M.

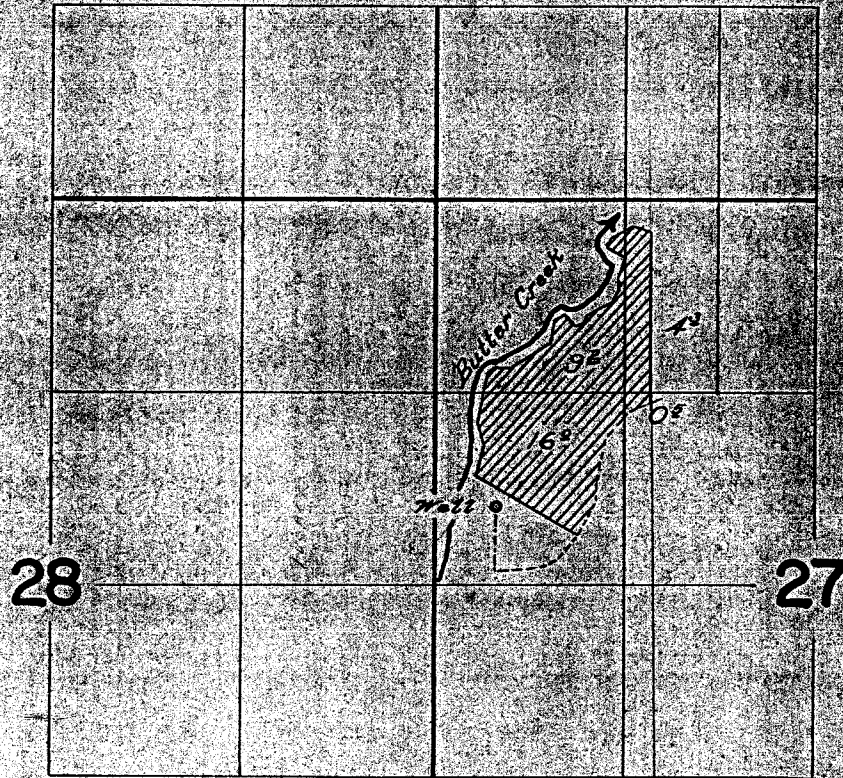

FINAL PROOF SURVEY UNDER

Application No. *26-488* Permit No. *U-441*
IN NAME OF

John F. Kilkenny

Surveyed *October 1, 1956* by *Thomas A. Latta*