


T.6N.R.35E.W.M.

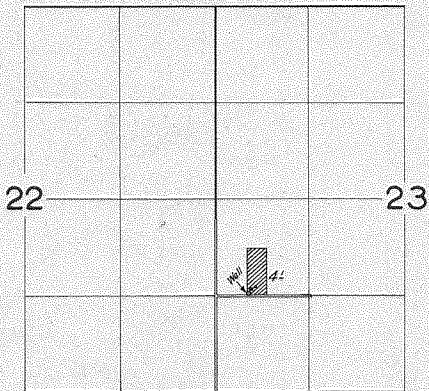

FINAL PROOF SURVEY
UNDER

Application No. **G-886** Permit No. **G-793**
IN NAME OF

C. E. EVANS

Surveyed April 24 1962, by *[Signature]*