


T.4N.R.35E.W.M.

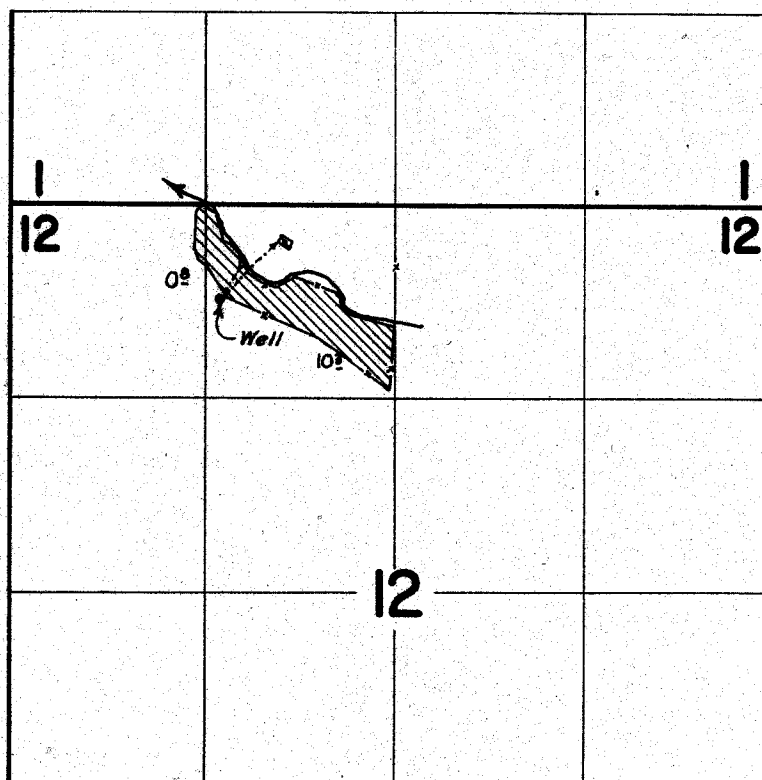

FINAL PROOF SURVEY
UNDER

Application No. **G-1261** Permit No. **G-1014**
IN NAME OF

GEORGE C. LIEUALLEN

Surveyed June 5, 1962, by *R. Jackson*