


T.6N.R.35E.W.M.

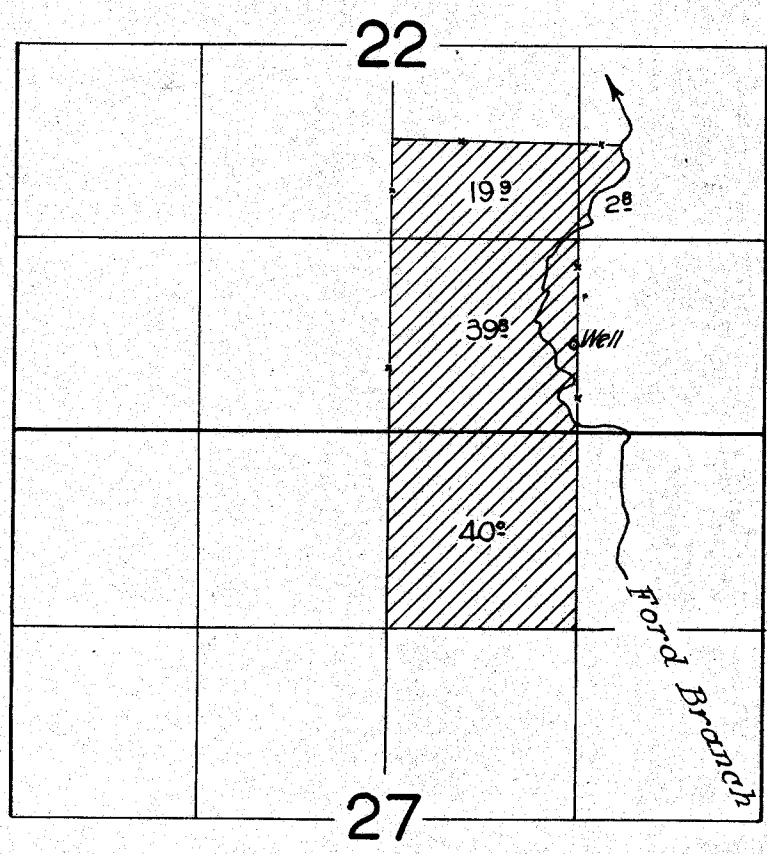

FINAL PROOF SURVEY UNDER

Application No. **G-1316** Permit No. **G-1189**
IN NAME OF

HERMAN & JOHN MILLER

Surveyed April 24, 1962, by *Alphonse*