


G-1197

31705

T.6N.R.35E.W.M.

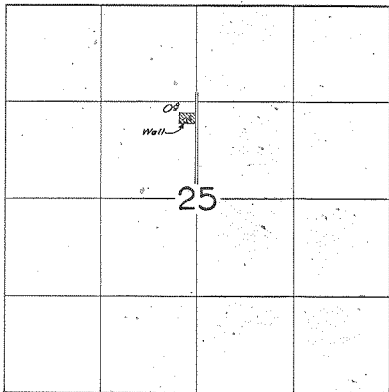

**FINAL PROOF SURVEY**  
UNDER

Application No. G-1064. Permit No. G-1197.  
IN NAME OF

CYRUS W. WRINKLE

Surveyed April 27 1962, by *[Signature]*