


# T.6N.R.35E.W.M.

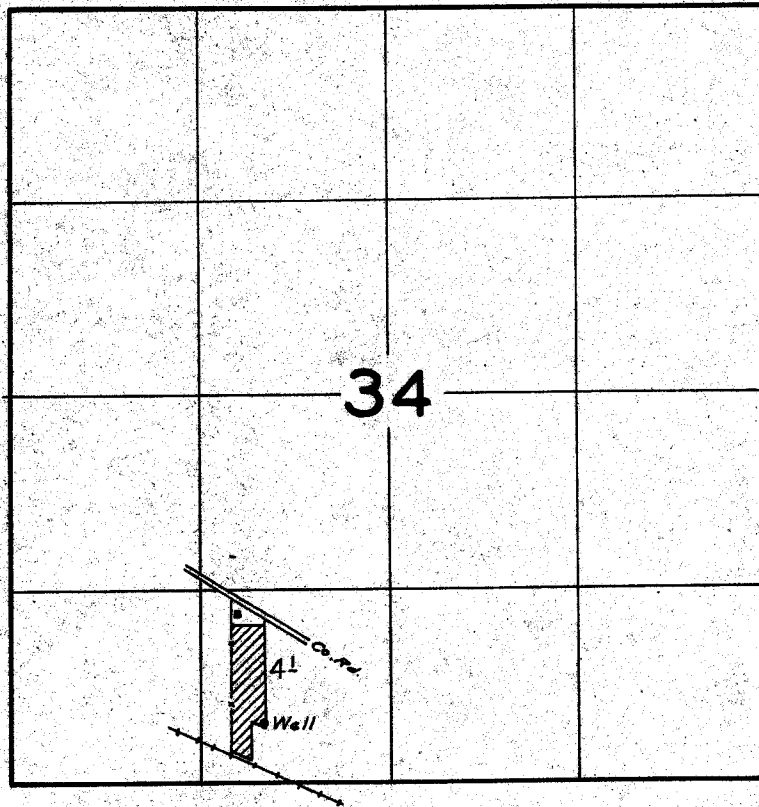

## FINAL PROOF SURVEY UNDER

Application No. G-1436 Permit No. G-1303  
IN NAME OF

ARDEN L. GAWITH

Surveyed April 25 1962, by *R. Jackson*