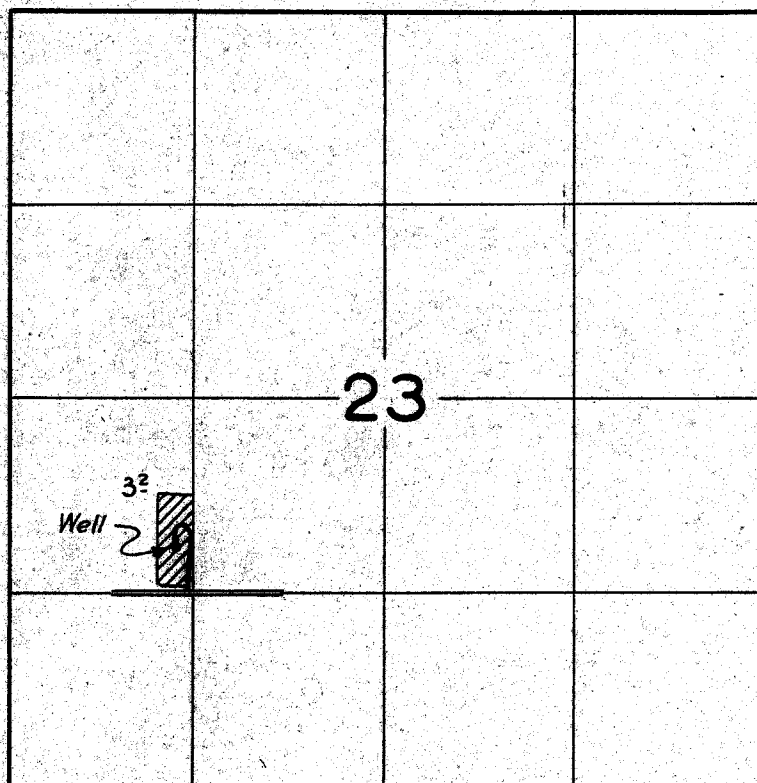


T.6N.R.35E.W.M.

**FINAL PROOF SURVEY**
UNDERApplication No. **G-1437** Permit No. **G-1304**
IN NAME OF**CHARLES E. HEARD**Surveyed May 2, 1962, by *R. Jackson*