


T.6N.R.35E.W.M.

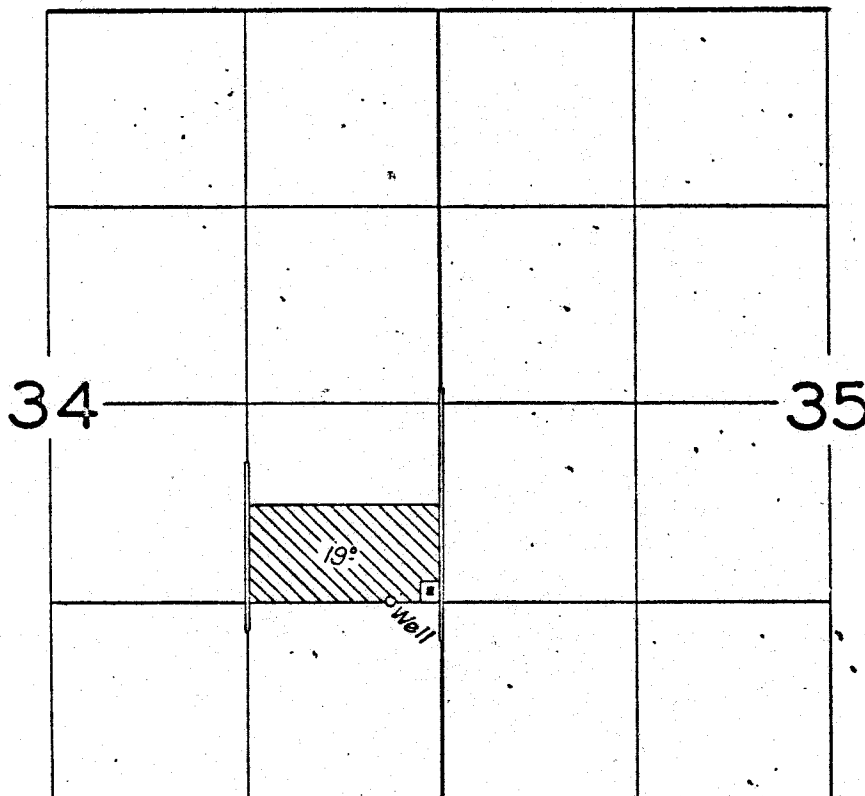

FINAL PROOF SURVEY UNDER

Application No. G-1662... Permit No. G-1522...
IN NAME OF

..... L. R. EDWARDS

Surveyed April 25 1962, by *E. Jackson*