


T.5N.R.29E.W.M.

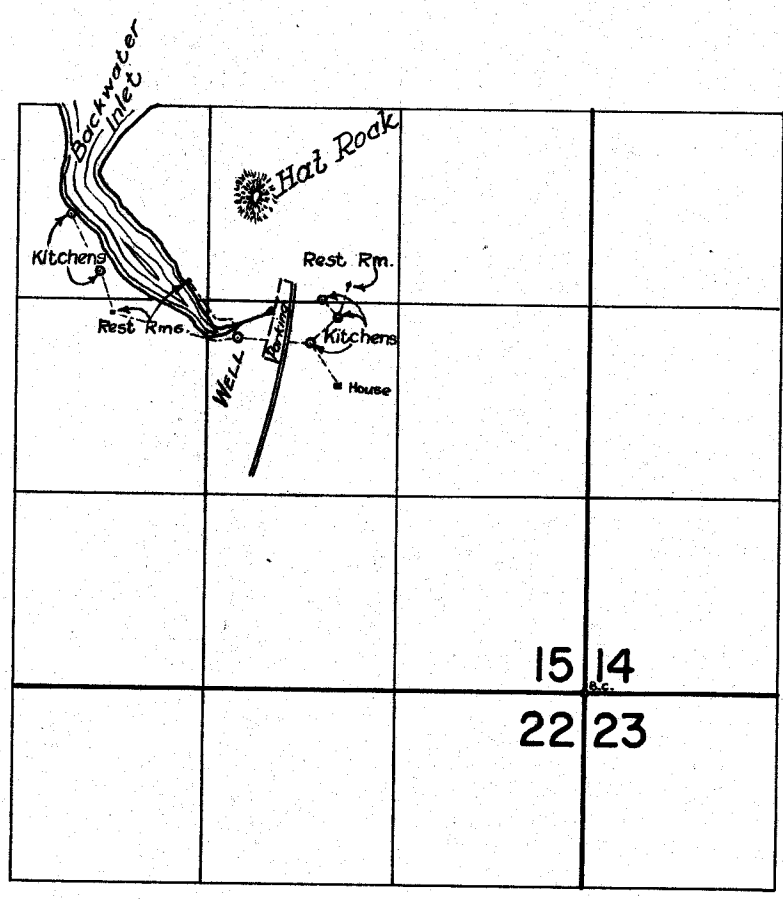

FINAL PROOF SURVEY UNDER

Application No. **G-1982** Permit No. **G-1824**
IN NAME OF

OREGON STATE HIGHWAY COMMISSION

Surveyed June...7... 1962, by *A. Jackson*