


T.2N.R.27E.W.M.

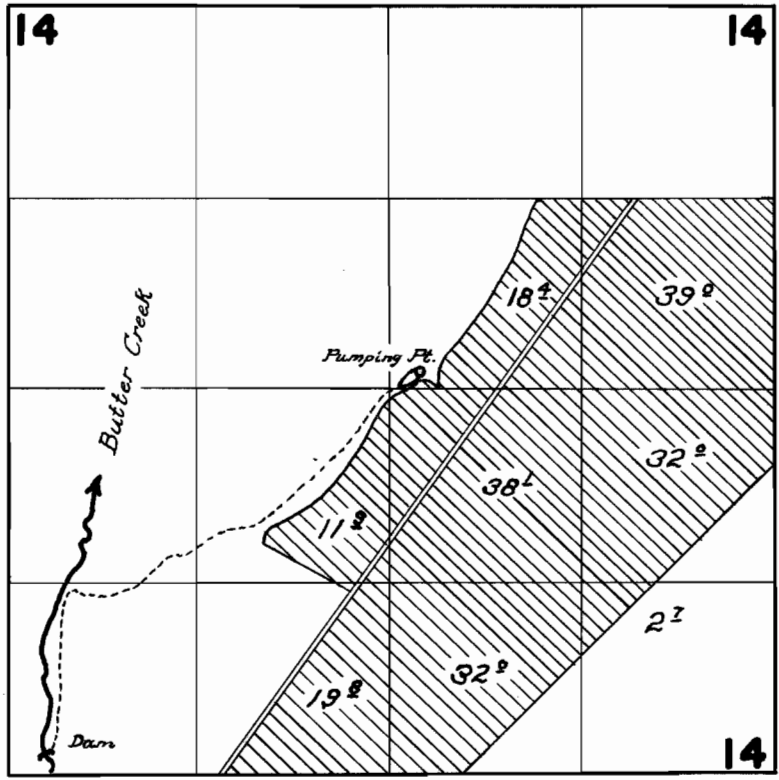

FINAL PROOF SURVEY UNDER

Application No. 32978 Permit No. 26080
IN NAME OF

Oscar D. McCarty

Surveyed Sept. 27, 1962, by Thomas R. Lauer