


T.6N.R.35E.W.M.

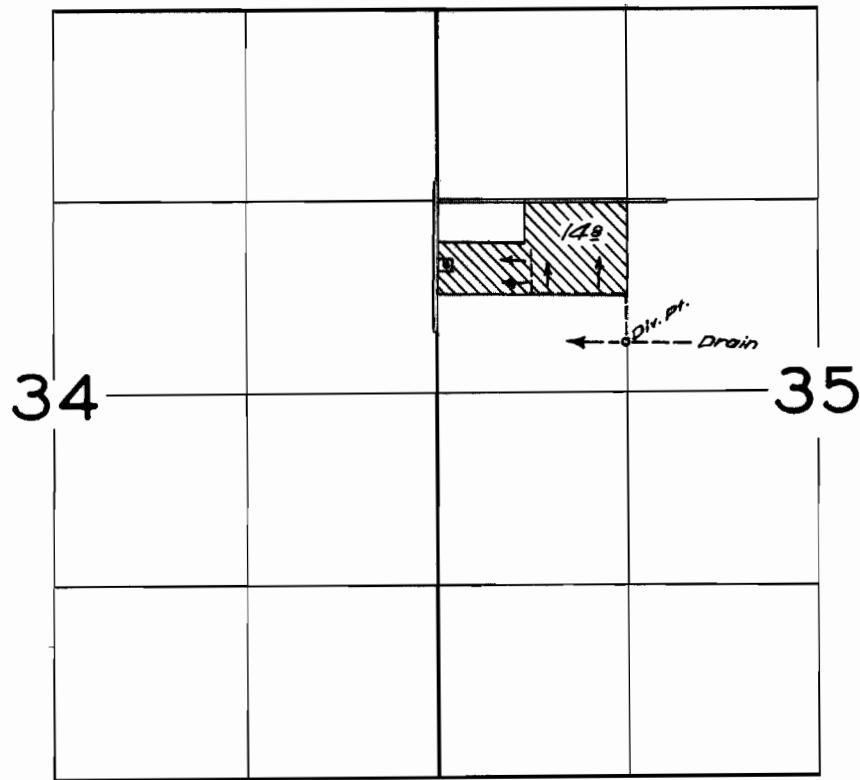

7/27/63
Section North
See file 52105
1/27/62 NZ-5F-62
NZ-5MM-67
[Signature]

FINAL PROOF SURVEY
UNDER

52105
Application No. **37271** Permit No. **27767**
IN NAME OF

CLAUDE BRADFIELD

Surveyed April 24, 1962, by *[Signature]*