


T. 8S. R. 16E. W.M.

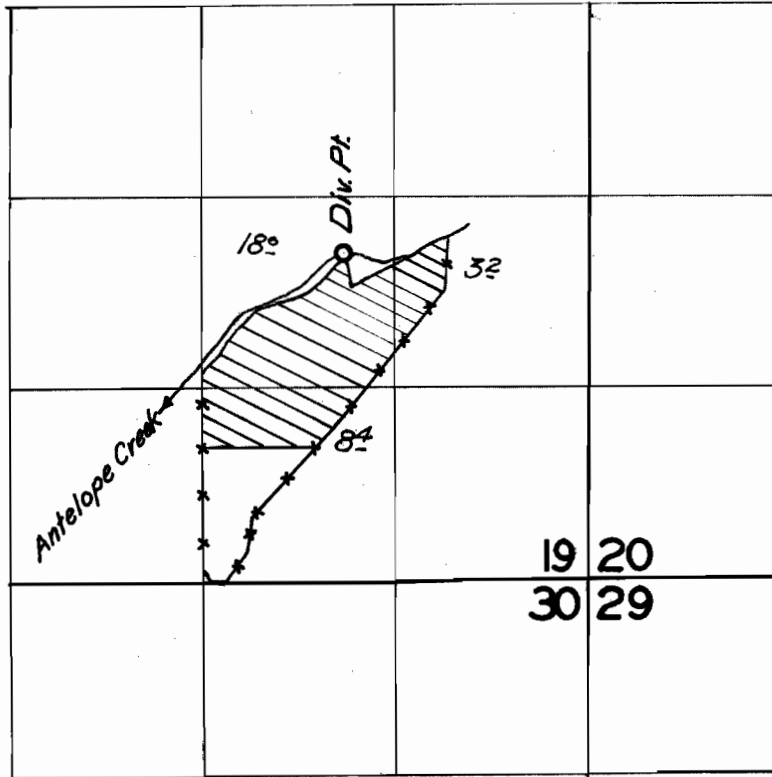

FINAL PROOF SURVEY UNDER

Application No. 32863 Permit No. 25958
IN NAME OF

Lawrence L. & Velma Ashley

Surveyed October 1962, by Carl R. Baker