


26811

T.1N. R.12E.W.M.

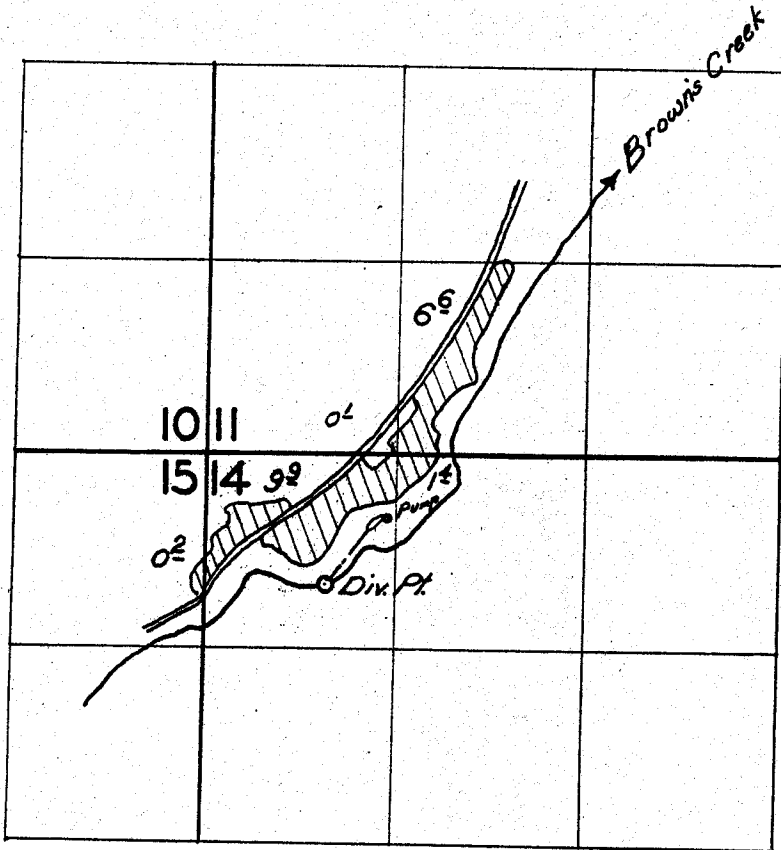

FINAL PROOF SURVEY UNDER

Application No. 33898 Permit No. 26811
IN NAME OF

Harvey L. Pullen

Surveyed June 12, 1963, by Larry J. Joubousek