


# T. 1 S. R. 2 W. W. M.

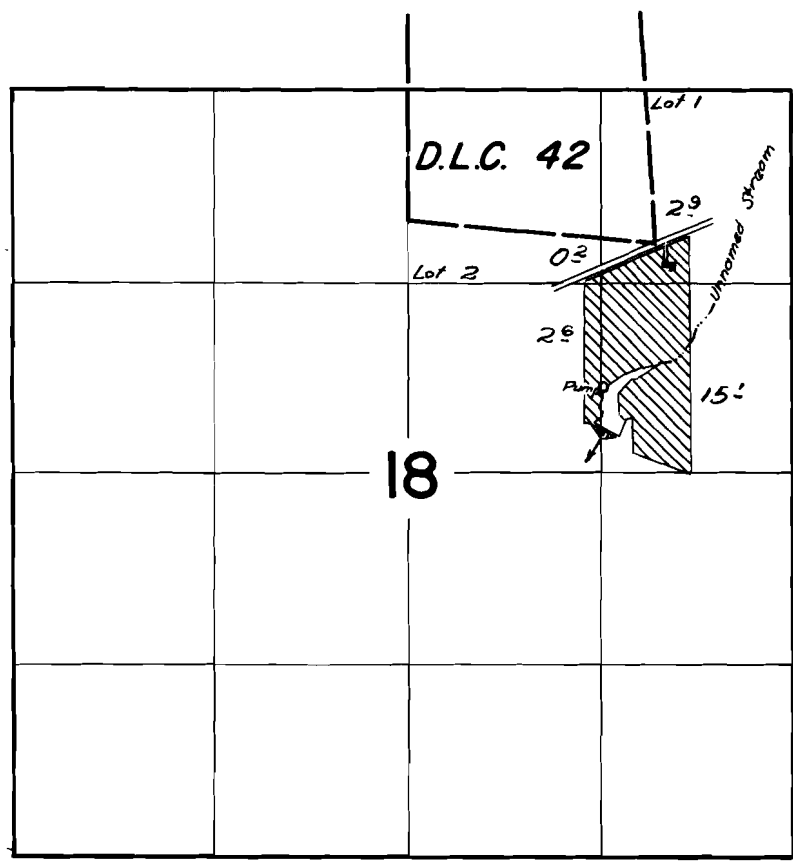


## FINAL PROOF SURVEY UNDER

Application No. R-30493 30496 Permit No. R-1826 24018  
 IN NAME OF

**VICTOR MADSEN**

Surveyed June 2, 1959, by *[Signature]*

# T. 1 S. R. 2 W. W. M.

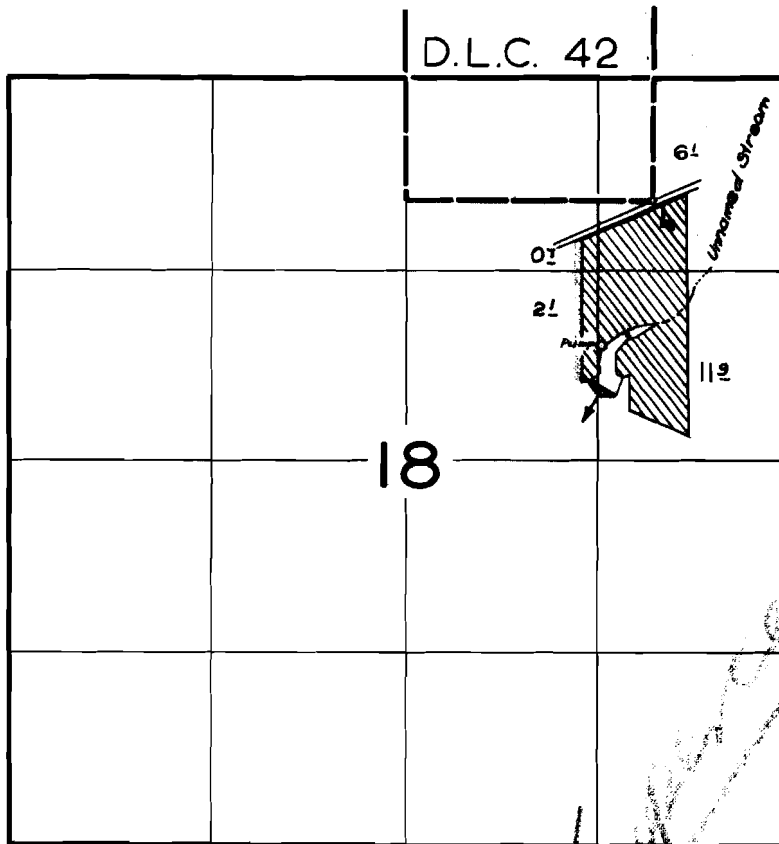

## FINAL PROOF SURVEY UNDER

Application No. *R-30493* ~~30496~~ Permit No. *R-1826* ~~24018~~  
IN NAME OF

*VICTOR MADSEN*

Surveyed *2 June* 1959, by *RH Jackson*