


T.I.S.R.2W.W.M.

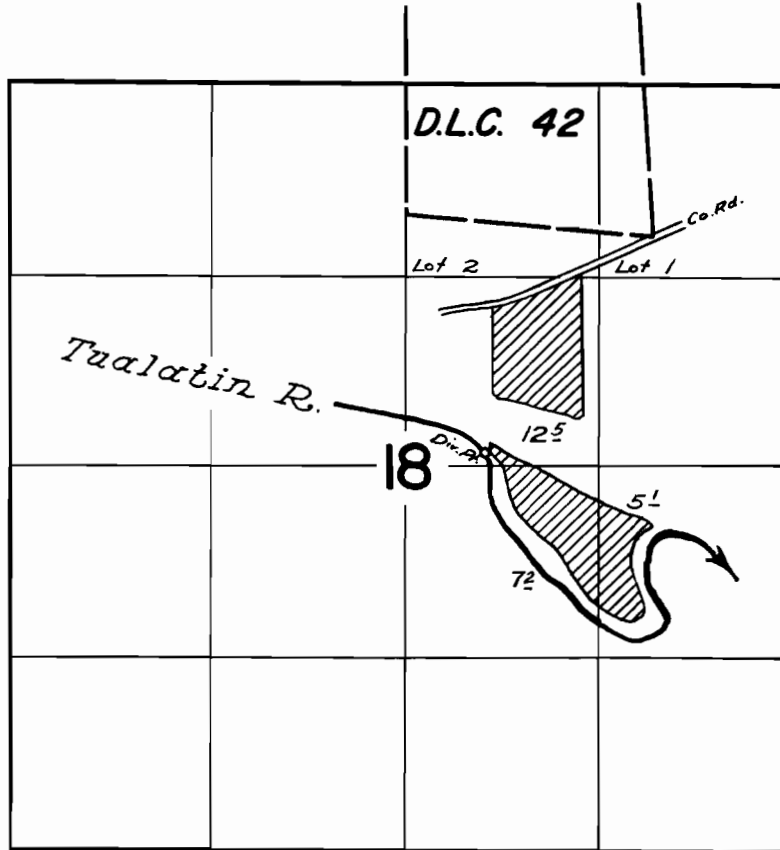

FINAL PROOF SURVEY
UNDER

Application No. **30737** Permit No. **24311**
IN NAME OF

ROGER J. MADSEN

Surveyed June 2, 1959, by *R. Jackson*