


# T. I N. R. 3 W. W. M.

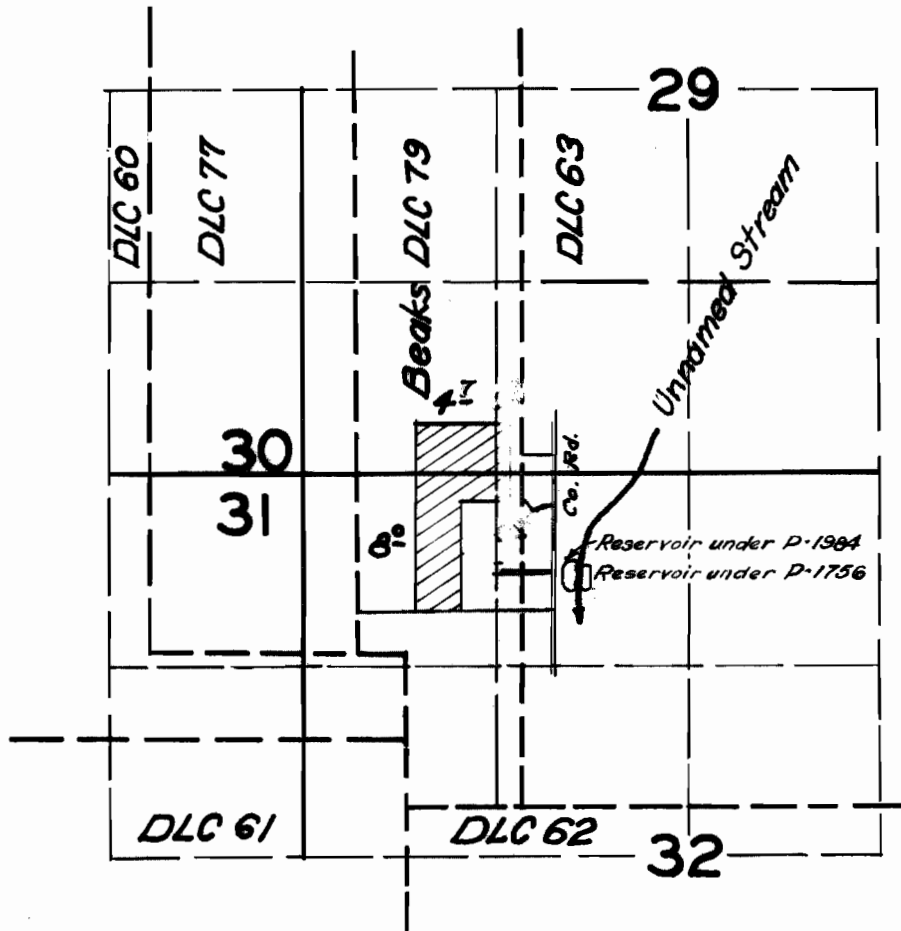

## FINAL PROOF SURVEY UNDER

Application No. 32975 Permit No. 26077  
IN NAME OF

Edward Porter

Surveyed 16 May 1962, by Carl R. Baker