


T9&10S. R.20E.W.M.

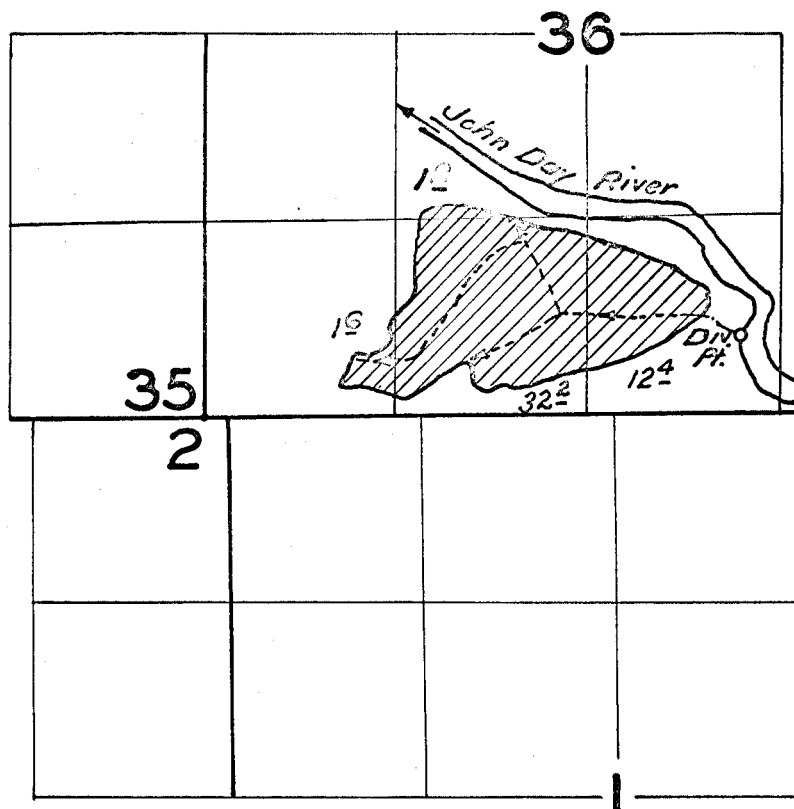

FINAL PROOF SURVEY
UNDER

Application No. 31441 Permit No. 24769
IN NAME OF

Connolly Brothers

Surveyed Sept. 27, 1962, by Ralph Jackson