


T.4S.R.3W.W.M.

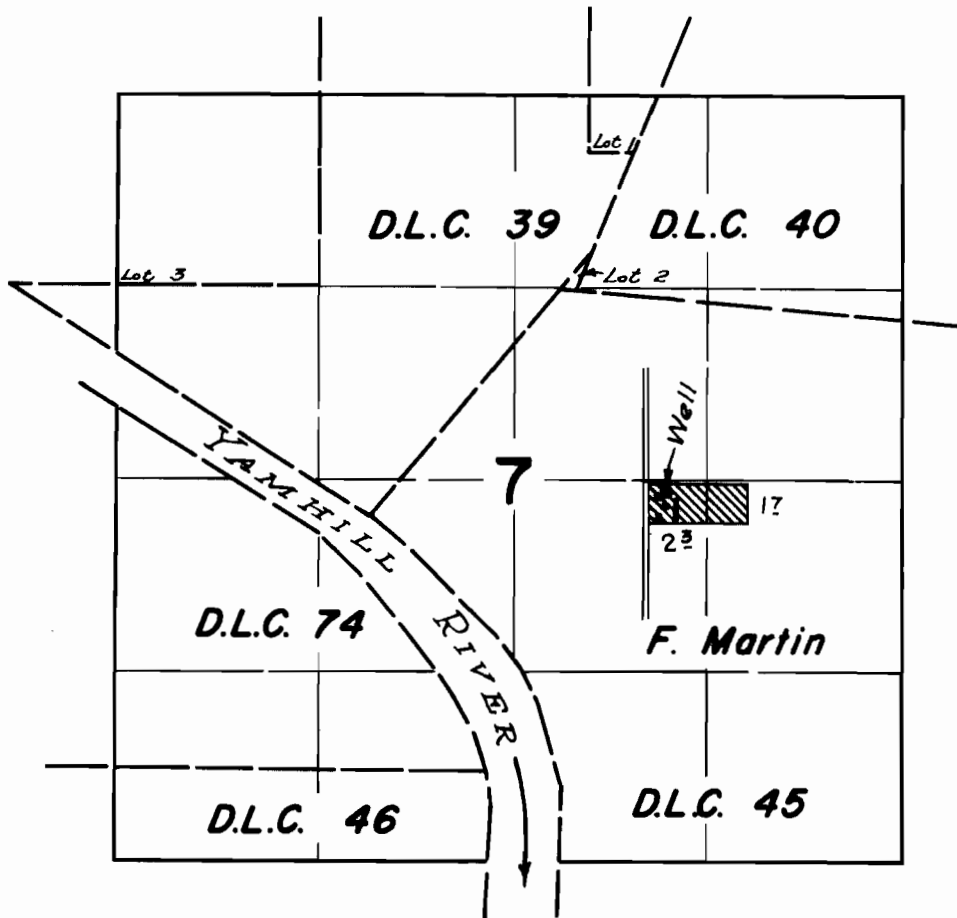

FINAL PROOF SURVEY
UNDER

Application No. ~~G-1186~~ Permit No. ~~G-1111~~.....
IN NAME OF

A. E. KESSLER

Surveyed July 25, 1962, by *[Signature]*