


T.3S.R.3W.W.M.

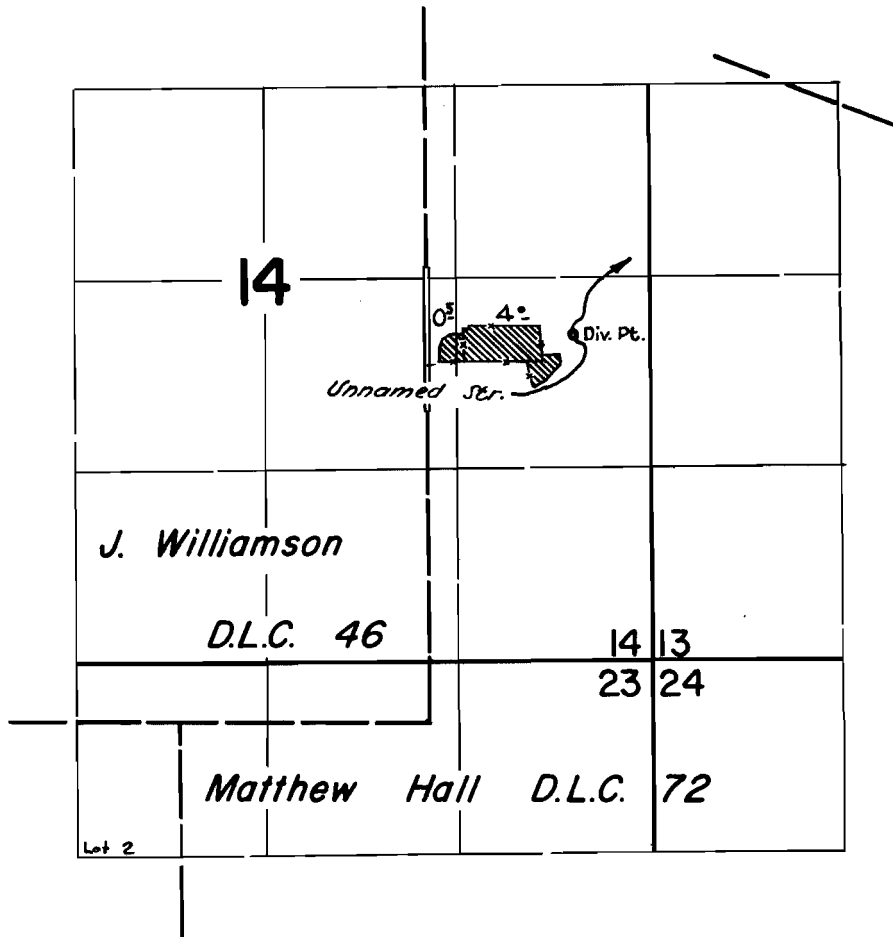

FINAL PROOF SURVEY UNDER

Application No. **32698** Permit No. **25808**
IN NAME OF

ROY ROBERTS

Surveyed July 26, 1962, by

R. Jackson