


# T. 4S.R. 3W.W.M.

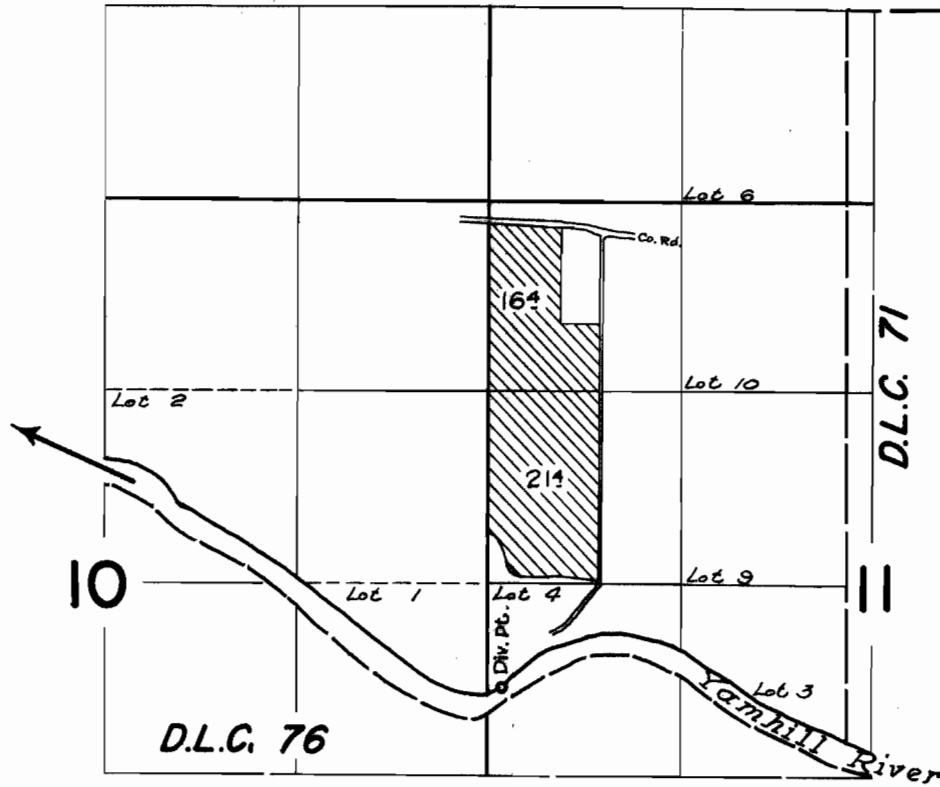

## FINAL PROOF SURVEY UNDER

Application No. 33361... Permit No. 26374...  
IN NAME OF

C. R. GIBBON

Surveyed July 25, 1962., by

*R. Jackson*