


T.4S.R.3W.W.M.

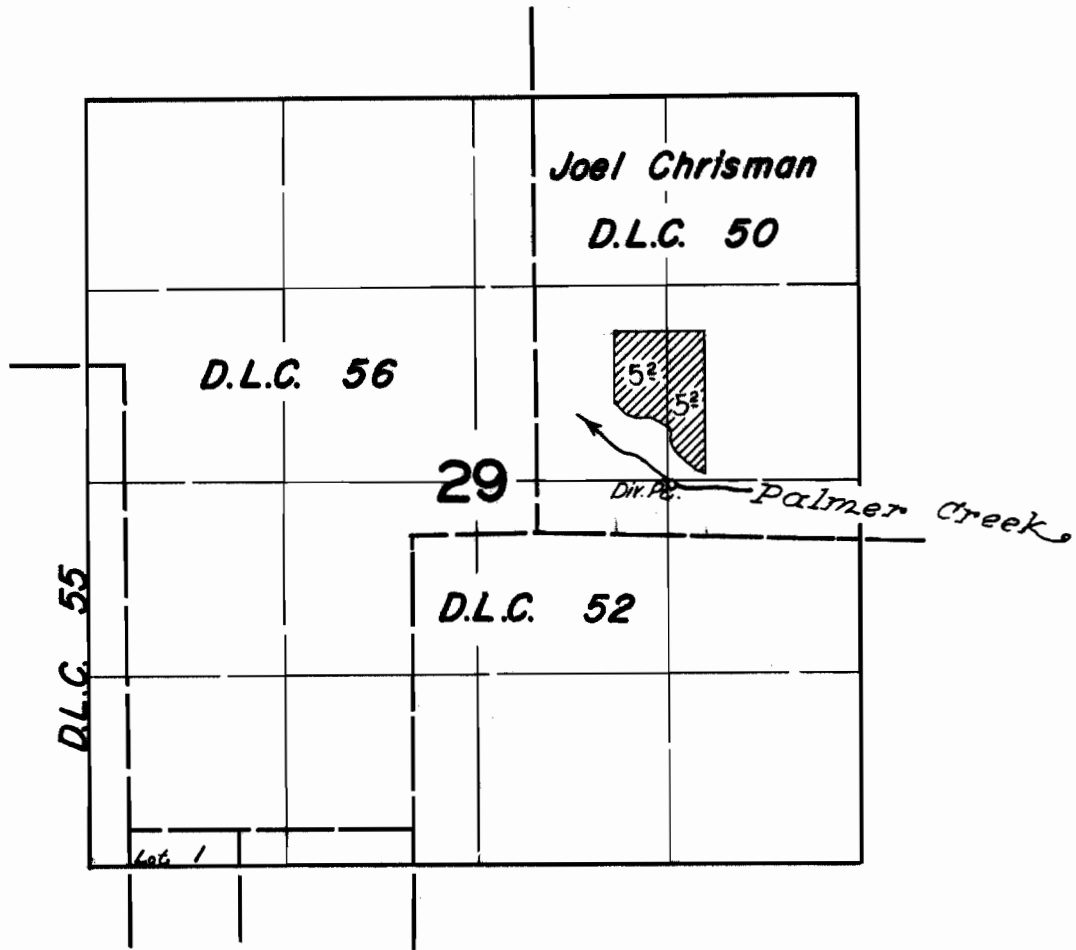

FINAL PROOF SURVEY
UNDER

Application No. **33632** Permit No. **26589**
IN NAME OF

GEORGE SCHEID

Surveyed July 24, 1962, by