


T. 4 S. R. 3 W. W. M.

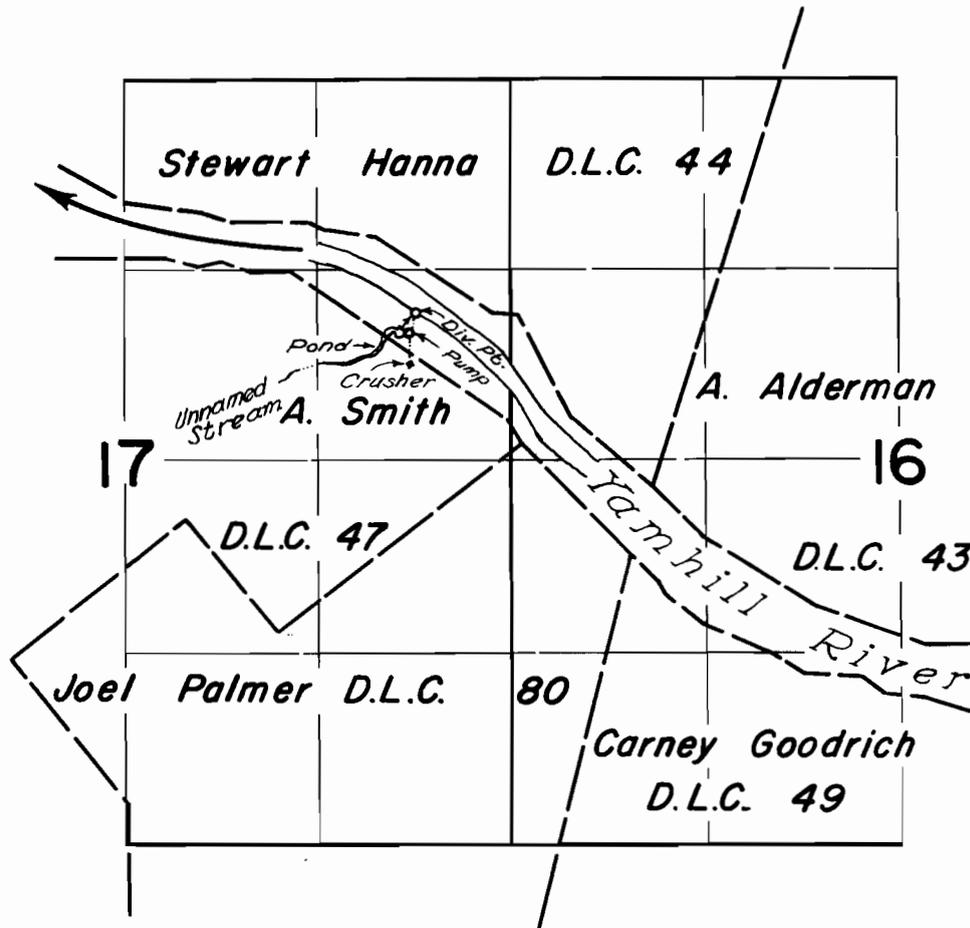

FINAL PROOF SURVEY
UNDER

Application No. 34476 Permit No. 27076
IN NAME OF

O. C. YOCOM COMPANY

Surveyed July 25, 1962, by

R. J. [Signature]