


T. 4 S. R. 4 W. W. M.

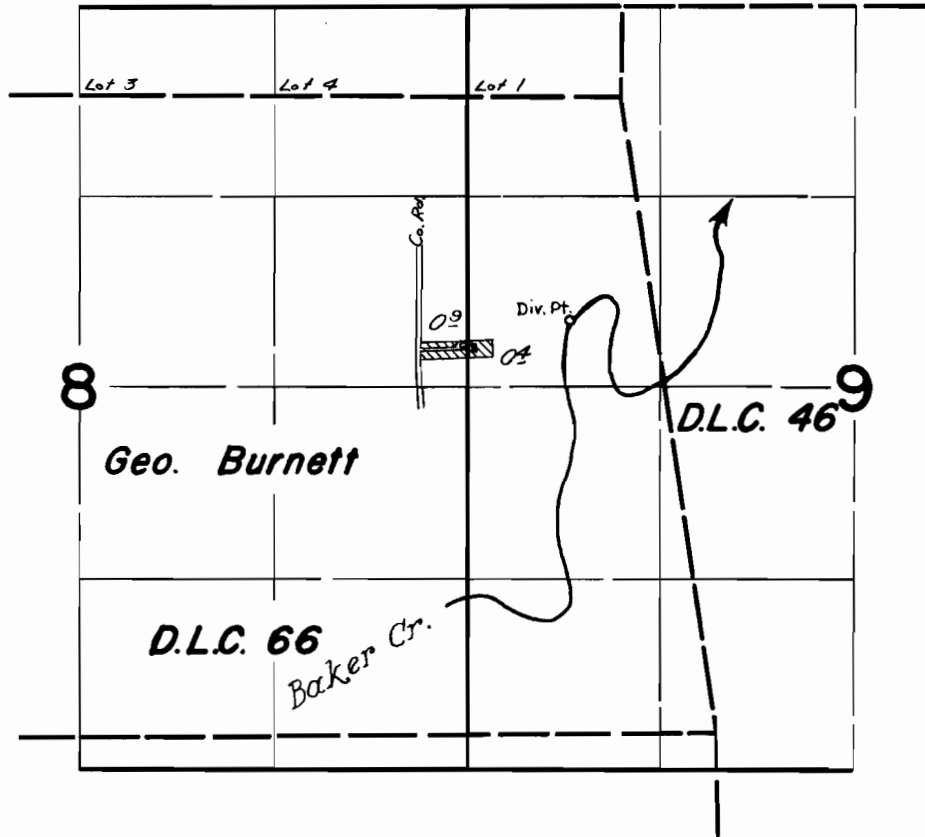

FINAL PROOF SURVEY UNDER

Application No. 34654 ... Permit No. 27220 ...
IN NAME OF

LEWIS D. REAVIS

Surveyed August 27 19.62, by *R. H. Johnson*