


T.29S.R.5W.W.M.

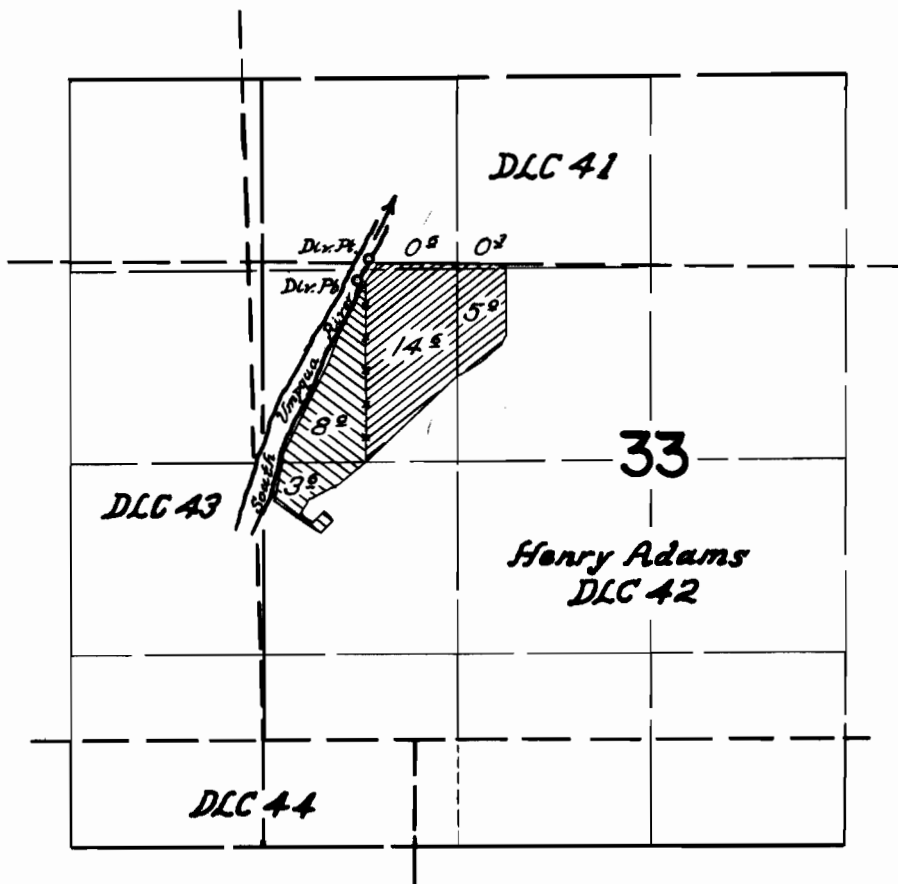

FINAL PROOF SURVEY UNDER

Application No. 32779 Permit No. 25864
IN NAME OF

Mrs. Lee Simpson & Glen G. & Doris Butler

Surveyed August 9 1962, by *Thomas R. Lauer*