


Sec. 10

# T.5S.R.31E.W.M.

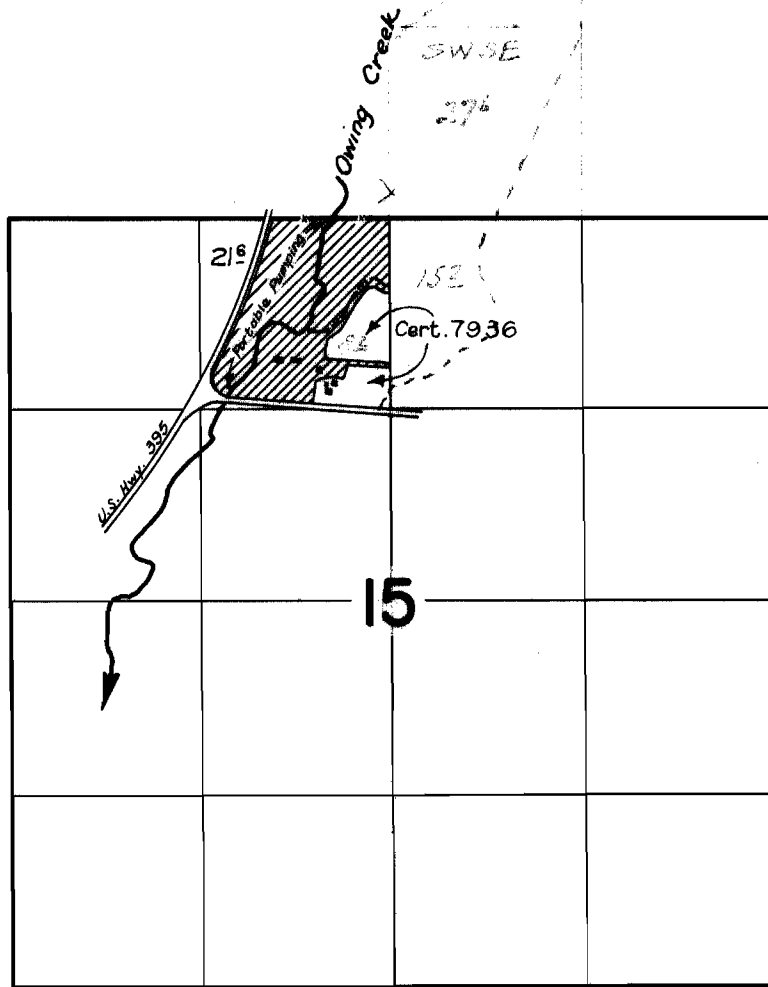

## FINAL PROOF SURVEY UNDER

**TRANSFER A-17**

Application No. \_\_\_\_\_ Permit No. \_\_\_\_\_  
IN NAME OF

**WALTER W. WAGNER**

Surveyed June 6, 1962., by *[Signature]*