


T. 5S. R. 1E. W.M.

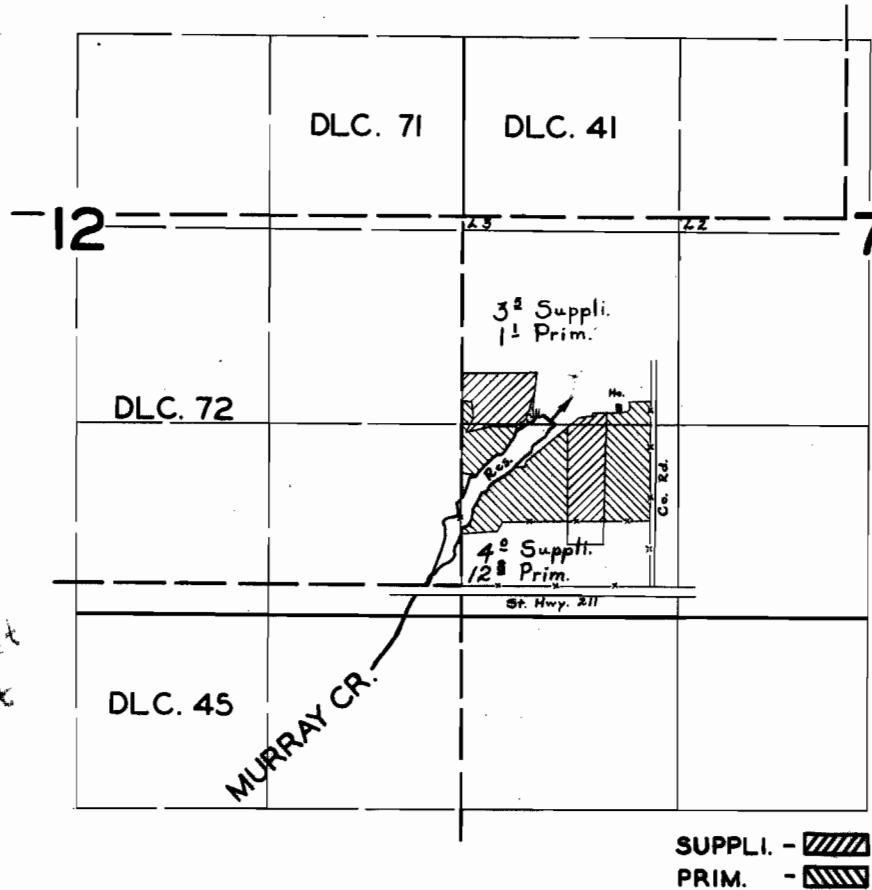

SEE
G-6515
for correct
layout

FINAL PROOF SURVEY
UNDER

R-29161 R-1623
Application No. 29162 Permit No. 22936
IN NAME OF

ELMER Y. GLICK

Surveyed APR. 30 1959, by M. BISH