


T.19S. R.1W.W.M.

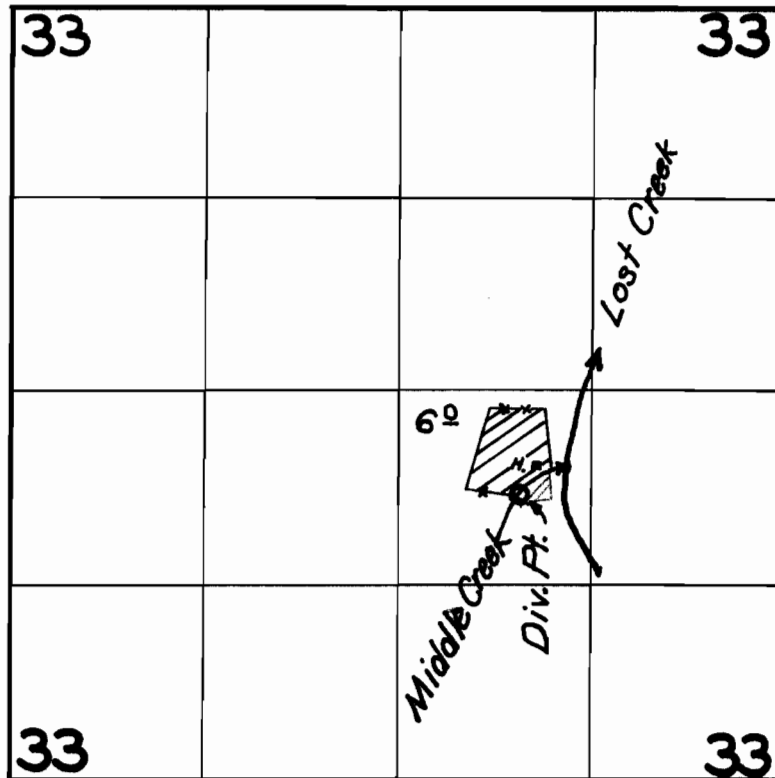


FINAL PROOF SURVEY
UNDER

Application No. 8069 Permit No. 5223
IN NAME OF

Orval W. Blakeley

Surveyed 21 May 1962, by Carl R. Baker

T.19S. R.1W.W.M.

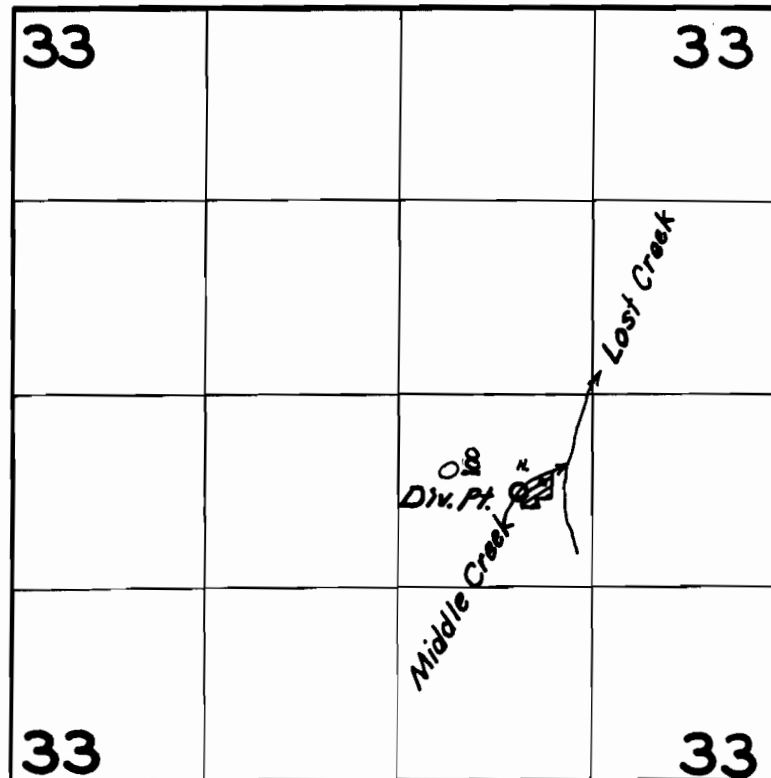

FINAL PROOF SURVEY
UNDER

Application No. 8069 Permit No. 5223
IN NAME OF

Edward J. Putschler

Surveyed 21 May 1962, by Carl R. Baker