


44° 33' 25"  
123° 19' 10" USB

# T.12S. R.5W.W.M.

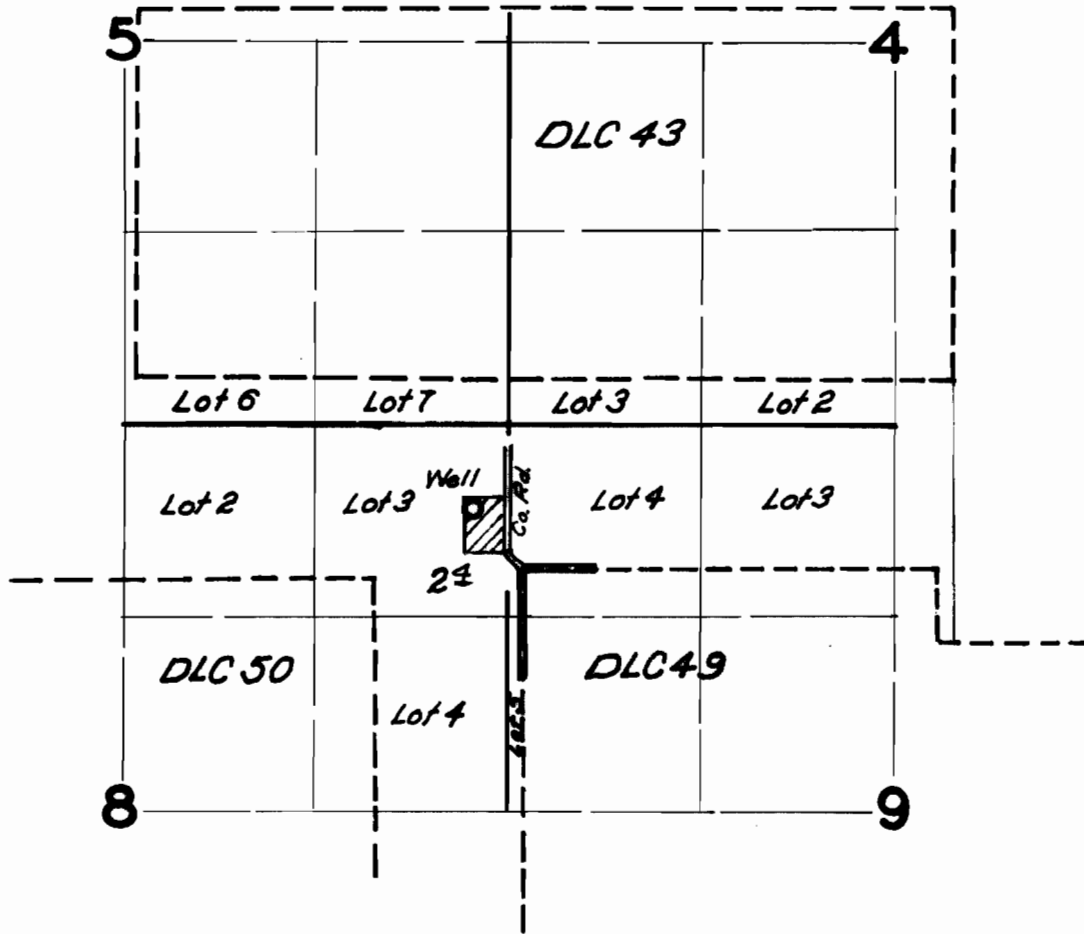

## FINAL PROOF SURVEY UNDER

Application No. *G-1151* Permit No. *G-1102*  
IN NAME OF

*Donald D. Russell*

Surveyed *5 Sept. 1962*, by *Carl R. Baker*