


T.1S.R.4E.W.M.

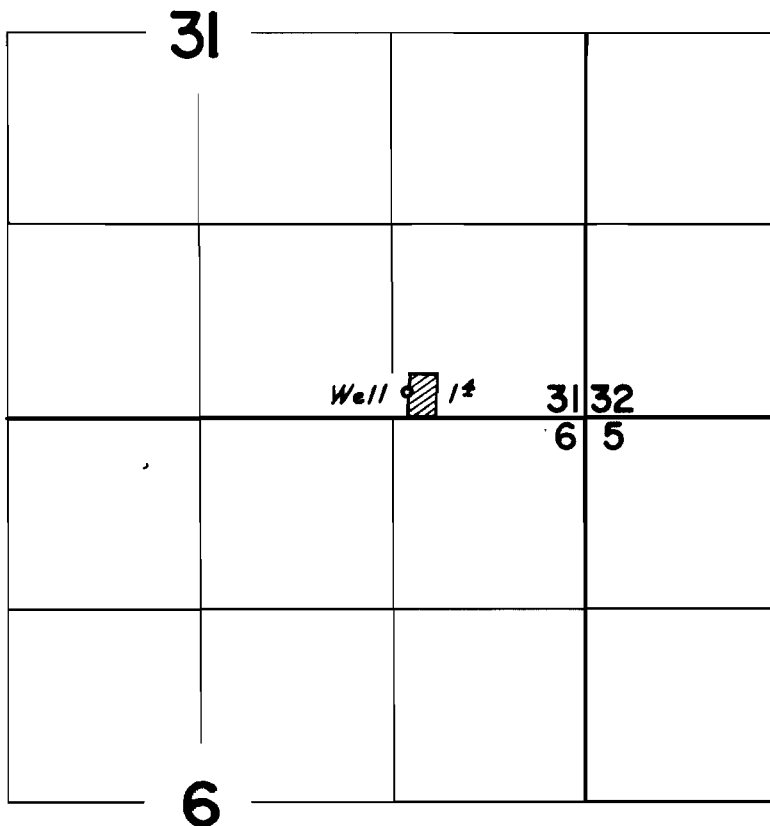

FINAL PROOF SURVEY UNDER

Application No. G-1271 Permit No. G-1182
IN NAME OF

Matt M. + Myrtle G. Kahn

Surveyed May 29 1962, by Thomas R. Lauer