


T. 8 N. R. 10 W. W. M.

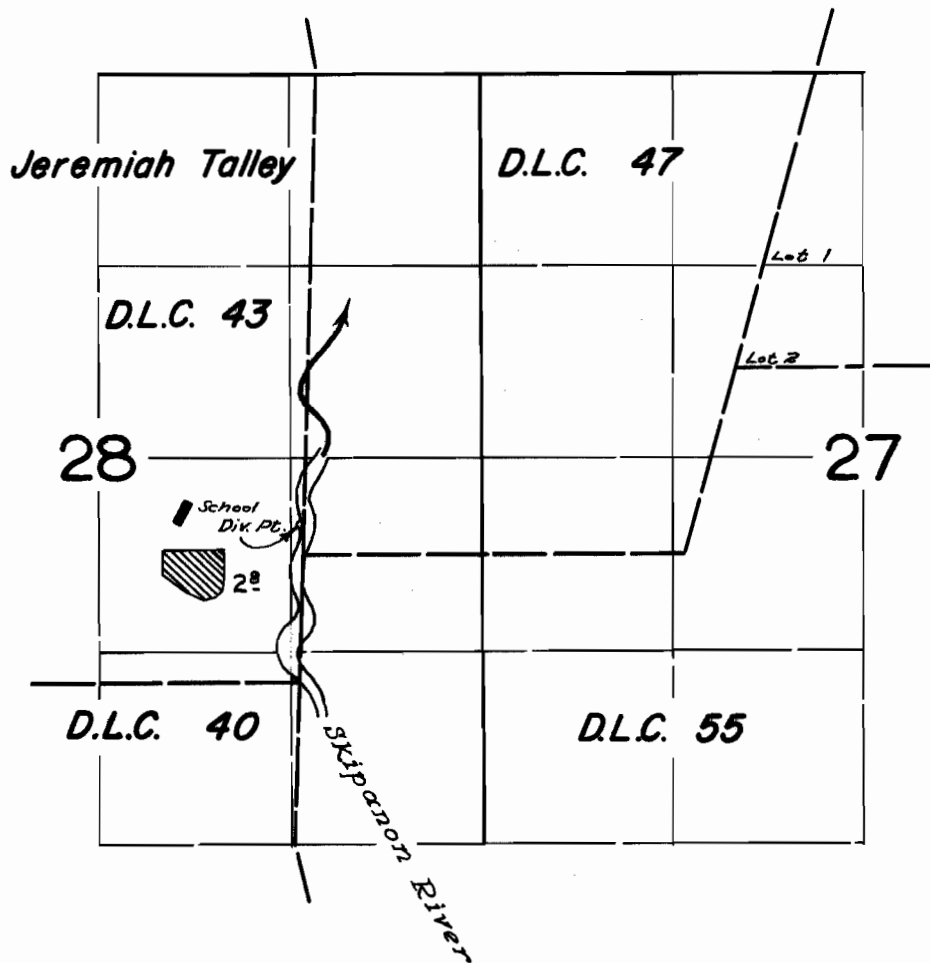

FINAL PROOF SURVEY
UNDER

Application No. **33498** Permit No. **26478**
IN NAME OF

SCHOOL DISTRICT NO. 30

Surveyed July 12, 1962, by *Alphason*