


T.3N.R.2W.W.M.

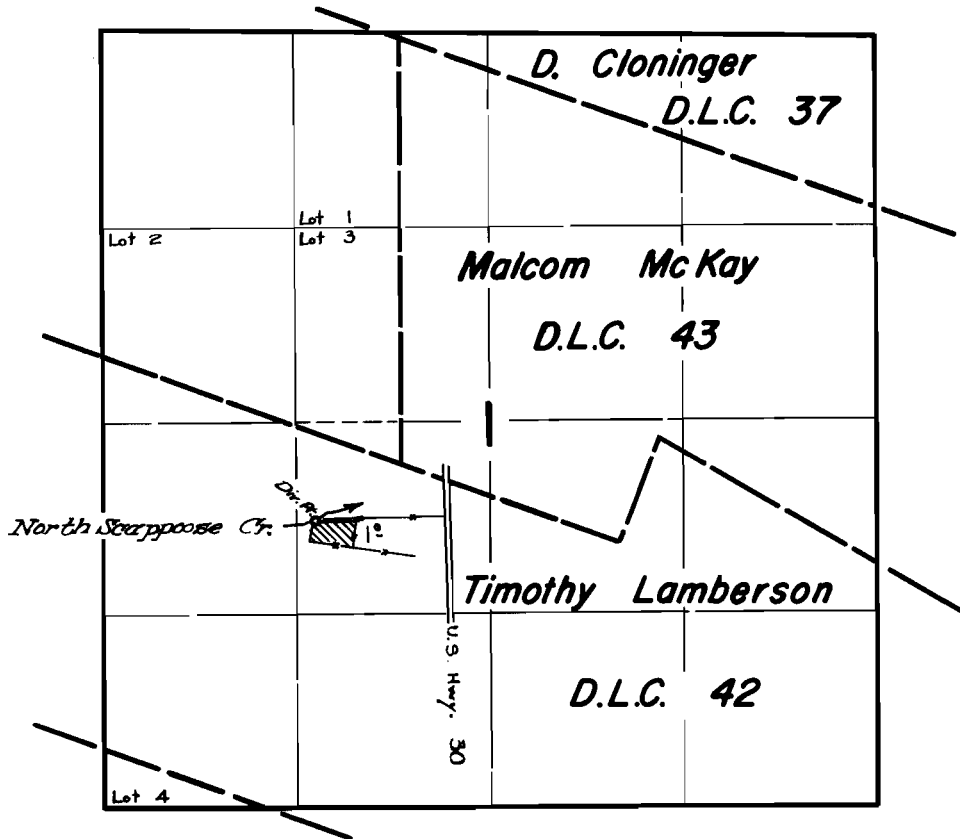

**FINAL PROOF SURVEY**  
UNDER

Application No. **28068** ... Permit No. **22078**..  
IN NAME OF

**ESTATE OF CHARLES F. JIMERSON**

Surveyed July 16, 1962., by *[Signature]*