


# T.4N.R.2W.W.M.

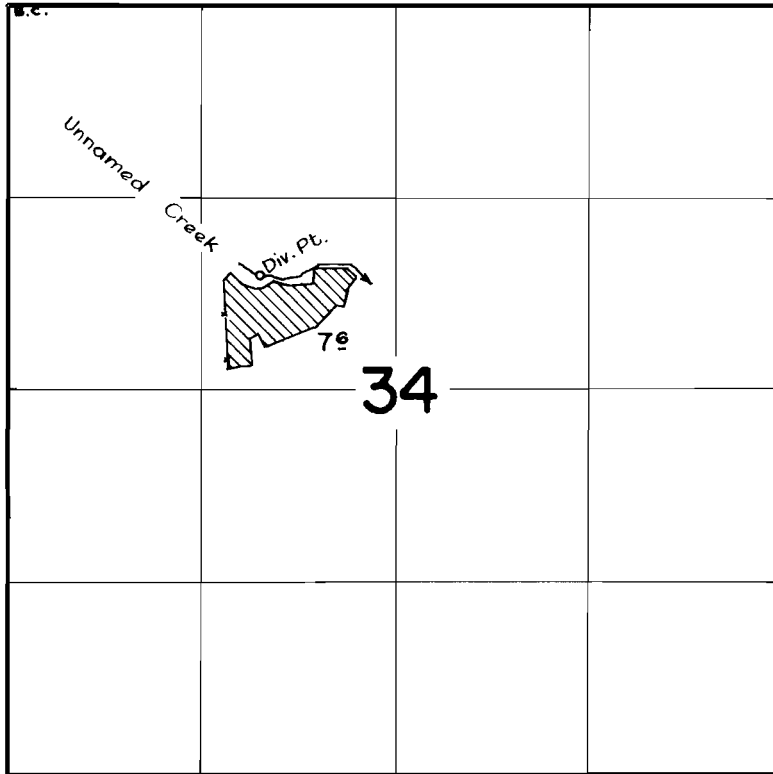

## FINAL PROOF SURVEY UNDER

Application No. 28015.... Permit No. 22048..  
IN NAME OF

.....  
**EARL S. KELLAR**  
.....

Surveyed July 18, 1960, by C. O. Bartels  
July 18, 1962, by R. H. Jackson