T.3N.R.2W.W.M.

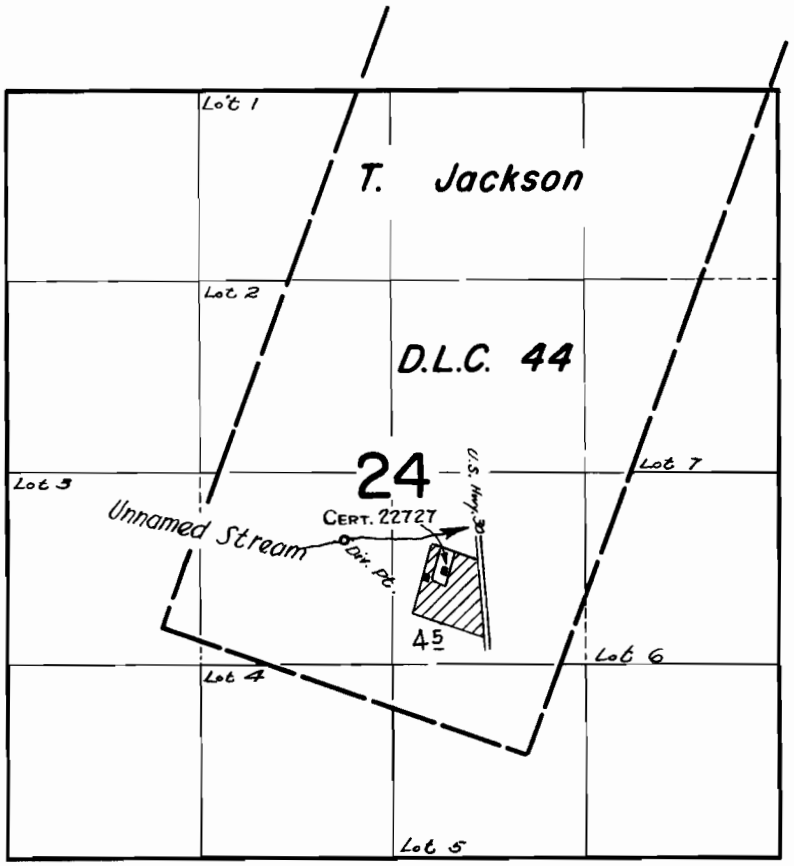

FINAL PROOF SURVEY
UNDER

Application No. **32486** Permit No. **25647**
IN NAME OF

HERBERT L. THOMAS

Surveyed July 19 1962, by W. H. Jackson

1962-L