


T.20&21S.R.10W.W.M.

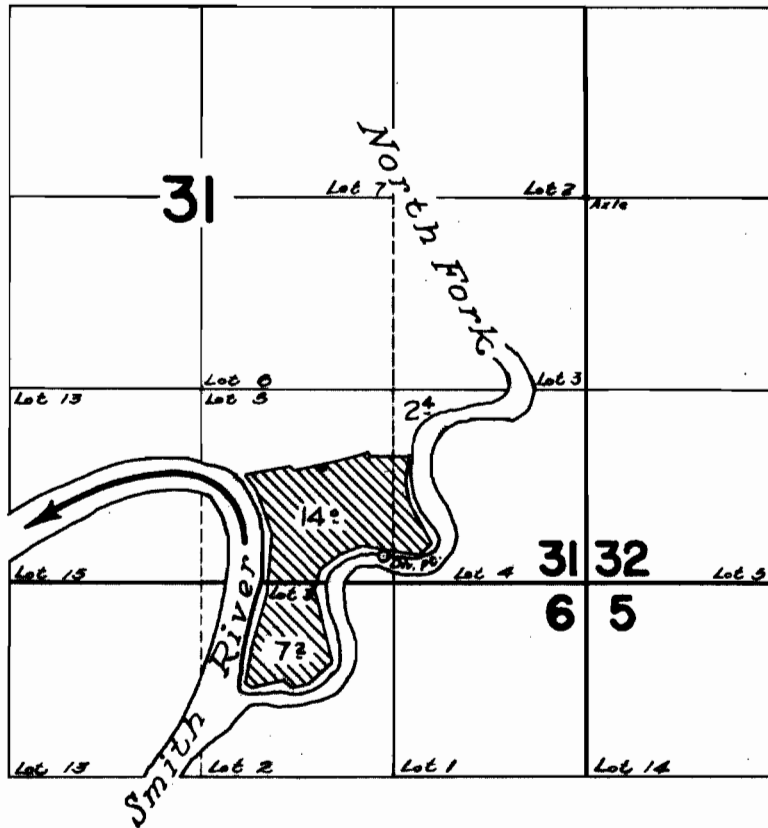

**FINAL PROOF SURVEY**  
UNDER

Application No. 33322... Permit No. 26357...  
IN NAME OF

.....Le Roy...G...Stemmerman.....

Surveyed June 28 1960, by C.O. Bartels...  
May 22 1962, by R.H. Jackson