


6

T. 13 S.R. 30 E.W.M.

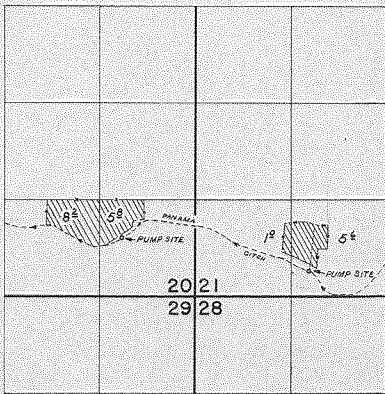

FINAL PROOF SURVEY UNDER

Application No. 32857 Permit No. 25955
IN NAME OF

J.A & Thelma Harrison

Surveyed Nov 13, 1962, by I.R. Lauer