


T. 41 S. R. 3 W. W. M.

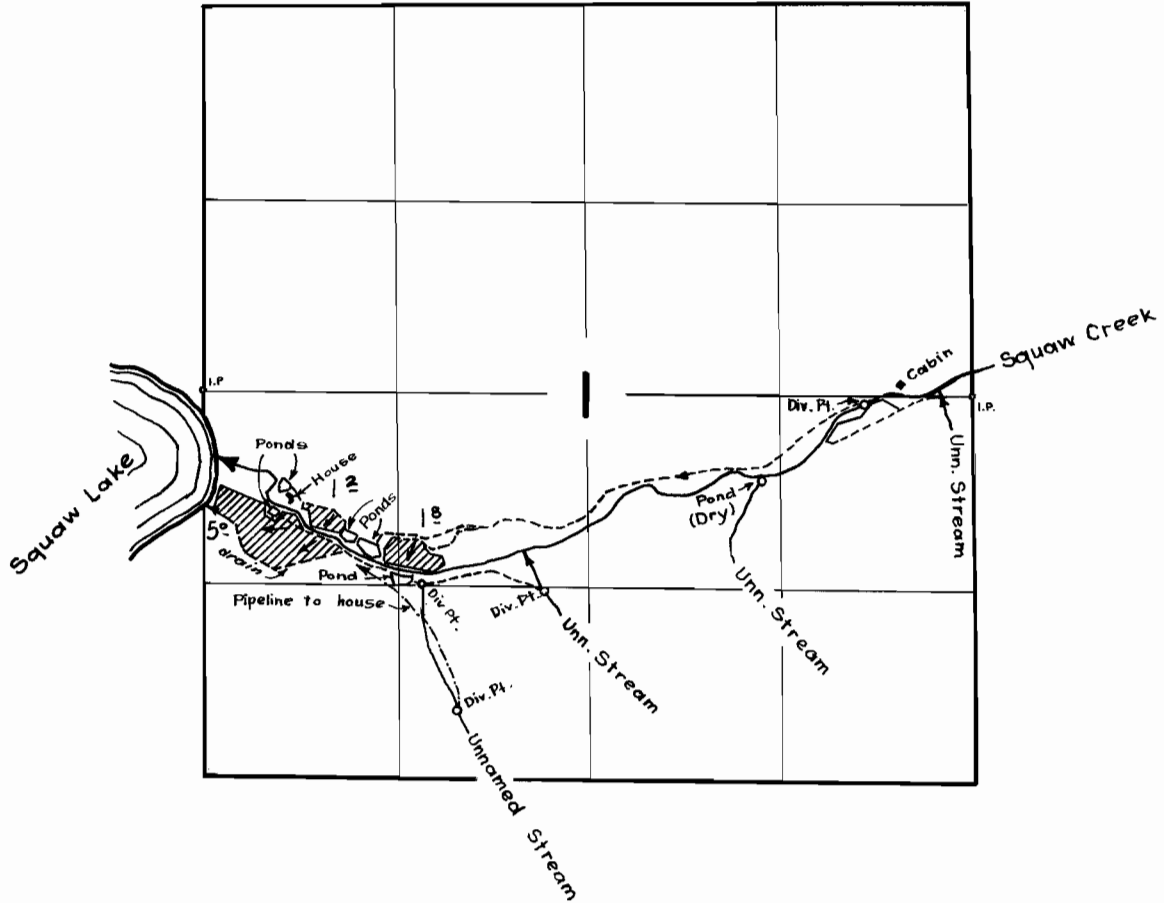

FINAL PROOF SURVEY UNDER

Application No. 25570 Permit No. 20167
29975 23612
IN NAME OF

A. C. PIERCE

Surveyed April 14 1961, by [Signature]