


Tr 29  
R 8 E

Permit No. 8982  
Application No. 12633

31253  
76030

Klamath River

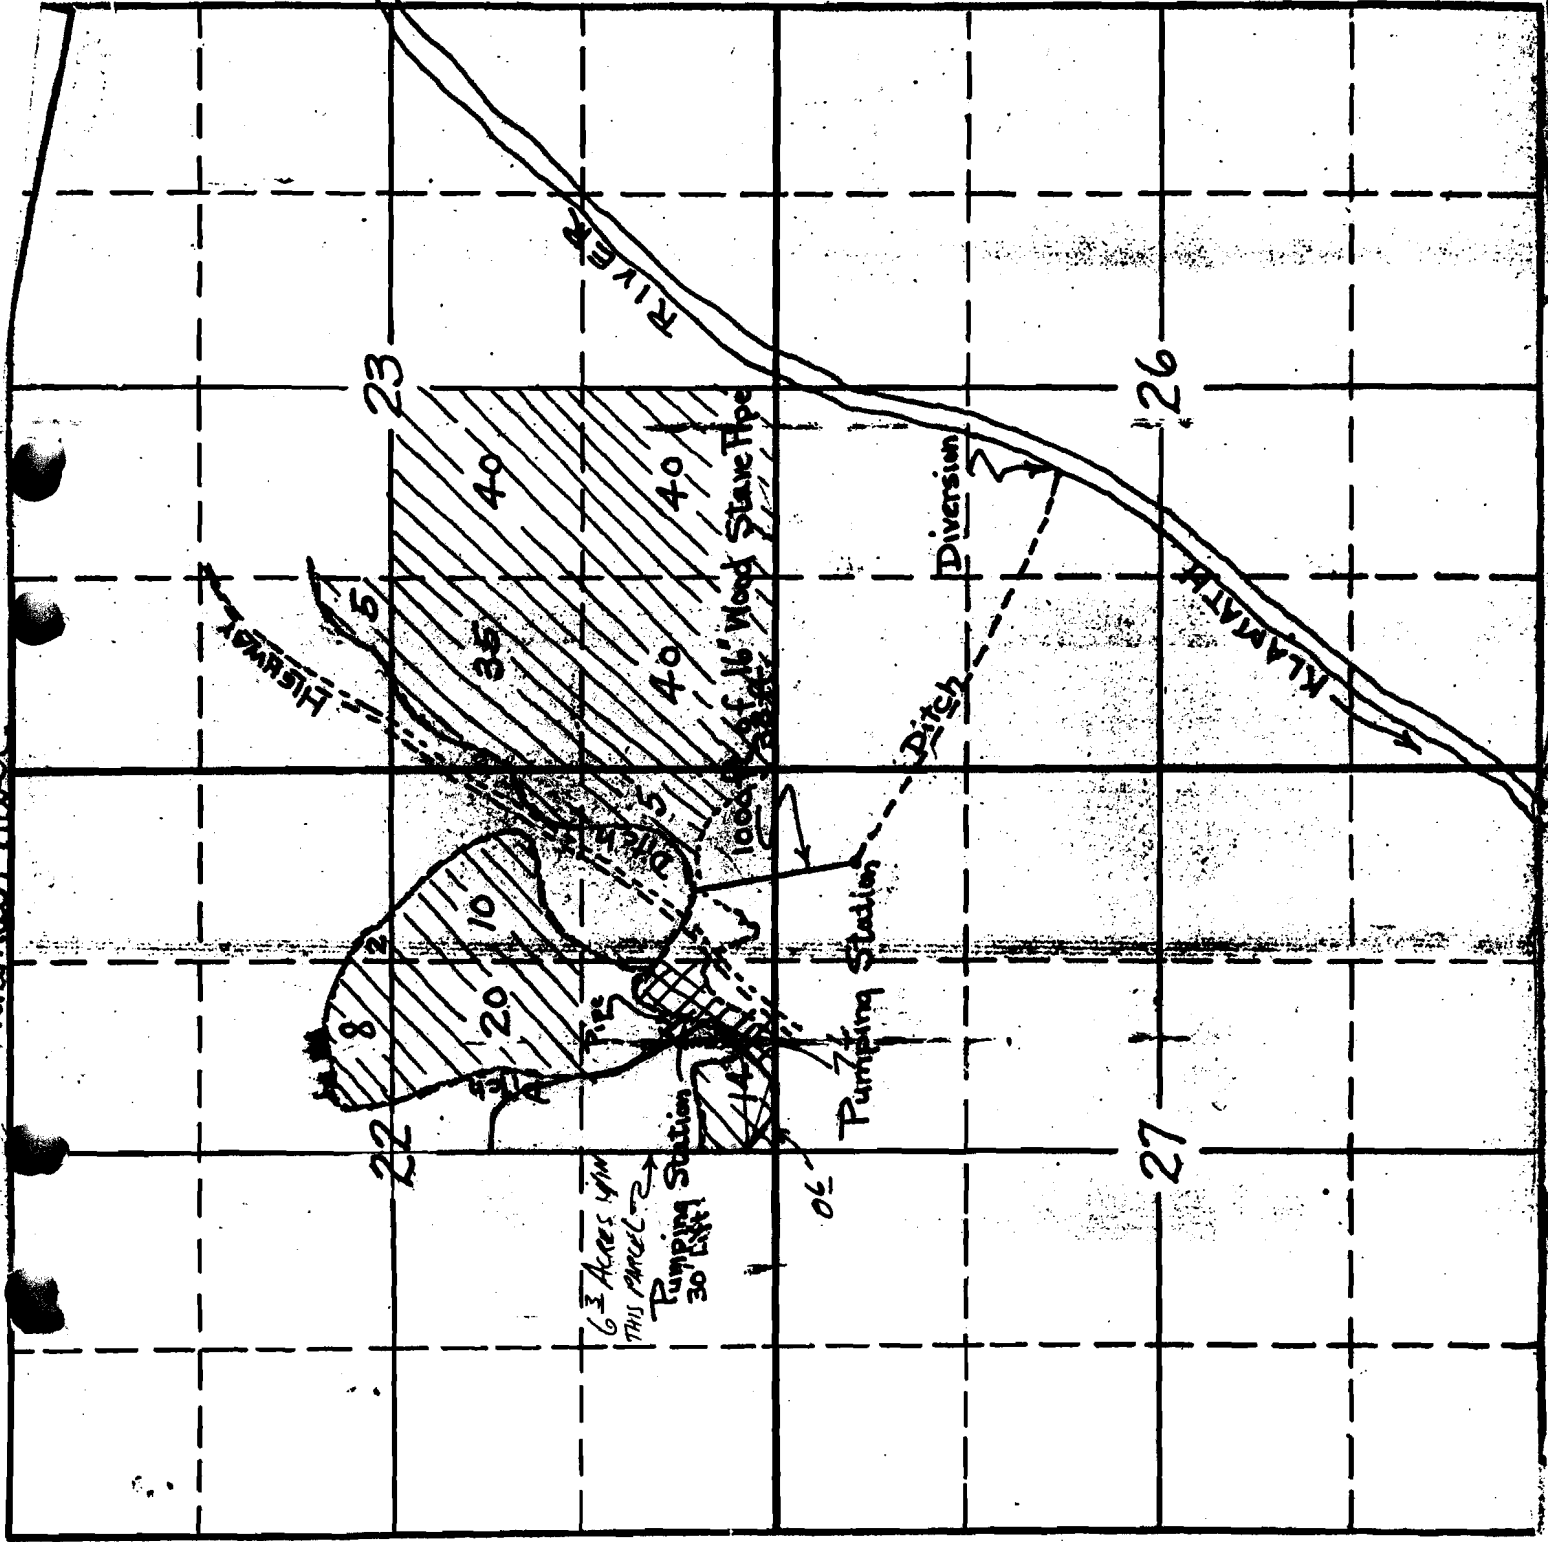

Ap. 12633  
Permit 8982.

ONLY 122  
ALLOWED  
69 - 18 = 51  
7.1 REMAINING

VOL 53 P 493

RMC  
2/18/99